

LINE	BEARING	LENGTH
L400	S76°59'34"E	53.35'
L401	S76°19'19"E	76.57'
L402	S66°29'06"E	25.32'
L403	N89°46'06"E	19.80'
L404	S69°09'51"E	19.20'
L405	S85°09'10"E	16.77'
L406	S81°41'22"E	33.39'
L407	N73°04'49"E	31.90'
L408	N75°40'05"E	22.93'
L409	N46°40'39"E	36.84'
L410	N84°53'09"E	37.15'
L411	N73°23'50"E	32.17'
L412	S87°24'13"E	55.23'
L413	S77°24'35"E	54.97'
L414	S73°02'01"E	30.70'
L415	S66°26'59"E	50.96'
L416	S47°09'09"E	48.53'
L417	S46°59'38"E	29.77'
L418	S36°36'04"E	43.06'
L419	S38°33'29"E	35.16'
L420	S56°03'34"E	28.60'
L421	S42°39'52"E	49.16'
L422	S74°55'18"E	34.92'
L423	S22°16'30"E	38.97'
L424	S19°12'01"E	51.54'
L425	S19°33'39"E	55.34'
L426	S16°37'08"E	54.06'
L427	S16°13'15"E	52.92'
L428	S08°40'10"E	52.75'
L429	S06°26'06"W	48.31'
L430	S63°03'12"W	44.37'
L431	S61°50'41"W	51.47'
L432	S53°41'57"W	51.60'
L433	S45°18'33"W	53.72'
L434	S44°25'30"W	41.50'
L435	S62°18'00"W	43.03'
L436	S49°16'32"W	19.69'
L437	N68°33'19"W	29.90'
L438	S84°29'14"W	55.10'
L439	S78°04'42"W	43.36'
L440	N89°22'50"W	53.47'
L441	S33°59'22"W	40.71'
L442	S55°14'37"W	47.47'
L443	S39°10'37"W	62.47'
L444	S29°01'47"W	48.30'
L445	S46°12'40"W	59.86'
L446	S49°20'27"W	60.44'
L447	S72°41'30"W	43.42'
L448	S25°43'28"W	40.17'
L449	S28°43'25"W	47.67'
L450	S58°13'22"W	41.27'

LINE	BEARING	LENGTH
L451	S68°09'41"W	27.45'
L452	S34°19'55"W	74.02'
L453	S50°54'27"W	95.02'
L454	N64°19'06"W	32.52'
L455	N10°24'21"E	16.17'
L456	S51°09'36"W	20.58'
L457	S57°58'50"W	42.05'
L458	S46°06'25"W	28.95'
L459	N46°06'25"E	27.71'
L460	N57°58'50"E	43.36'
L461	N59°49'08"E	55.99'
L462	N22°02'23"E	40.86'
L463	N08°38'10"W	33.80'
L464	N11°22'55"W	35.74'
L465	N35°05'42"E	10.70'
L466	N10°26'01"E	14.49'
L467	N02°37'43"W	19.30'
L468	N65°54'11"W	34.08'
L469	N54°12'07"W	30.20'
L470	N39°43'15"W	31.29'
L471	N64°00'35"W	37.23'
L472	N71°50'45"W	30.01'
L473	N00°39'18"W	34.64'
L474	N46°24'14"W	56.44'
L475	N57°25'54"W	48.48'
L476	N79°00'19"W	47.86'
L477	N76°26'56"W	60.86'
L478	N09°31'57"W	32.61'
L479	S76°26'56"E	72.97'
L480	S79°00'19"E	52.91'
L481	S57°25'54"E	56.93'
L482	S47°00'30"E	60.99'
L483	N74°58'24"E	39.38'
L484	N44°22'41"E	70.35'
L485	N85°36'04"E	44.41'
L486	N70°17'56"E	53.54'
L487	N58°49'45"E	37.66'
L488	N61°49'43"E	102.77'
L489	N64°11'00"E	49.92'
L490	N37°51'51"E	64.64'
L491	N72°03'54"E	60.62'
L492	N34°48'10"E	59.05'
L493	N29°36'32"E	45.39'
L494	N57°11'49"E	62.43'
L495	N32°45'06"E	44.54'
L496	N20°20'44"E	62.14'
L496A	N00°25'46"W	86.34'
L497	N26°45'54"W	53.46'
L498	N81°19'00"W	49.26'
L499	N89°51'58"W	50.50'
L500	N87°51'48"W	45.35'
L501	N71°48'12"W	56.96'
L502	N50°51'46"W	54.18'
L503	N45°57'53"W	54.22'
L504	N63°12'42"W	152.63'

CURVE	RADIUS	LENGTH	TANGENT	CHORD	BEARING	DELTA
C400	5564.29'	30.32'	15.16'	30.32'	N35°36'35"W	00°18'44"

LINE	LENGTH	BEARING
L1	95.62'	N 27°41'54" E
L2	48.69'	N 22°41'57" W
L3	145.69'	S 49°46'13" E

CURVE	RADIUS	LENGTH	TANGENT	CHORD	BEARING	DELTA
C1	5564.29	739.70	370.40	739.16	N 45°08'53" W	07°37'00"
C2	905.00	1410.51	893.99	1272.02	S 68°04'04" E	89°17'59"
C3	1200.00	628.81	321.80	621.64	S 38°25'50" E	30°01'24"
C4	5564.29	904.30	453.15	903.30	N 36°40'41" W	09°18'42"


**LEGEND**  
 MBS = MINIMUM BUILDING SETBACK  
 PDE = PUBLIC DRAIN EASEMENT  
 CSSR = CMUD SANITARY SEWER R/W  
 C.M. = CONCRETE MONUMENT  
 R/W = RIGHT-OF-WAY  
 CMUD = CHARLOTTE MECKLENBURG UTILITY DEPARTMENT  
 FND= FOUND  
 DOT MON=NORTH CAROLINA DEPARTMENT OF TRANSPORTATION MONUMENT  
 TDE= TEMPORARY DRAINAGE EASEMENT  
 (C/A) = CONTROL ACCESS

**ESP ASSOCIATES, P.A.**  
 engineering·surveying·planning

10915 Southern Loop Boulevard  
 Pineville, NC 28134 (704) 583-4949

NO.	DATE	REVISION	BY
<p><b>WHITEHALL CORPORATE CENTER PHASE II</b>                  OWNER: MOODY LAKE OFFICE PARK DEVELOPMENT L.P.</p> <p>LOCATED IN STEELE CREEK TOWNSHIP                  MECKLENBURG COUNTY, NORTH CAROLINA</p> <p><b>AAC REAL ESTATE SERVICES, INC.</b>                  5950 FAIRVIEW ROAD                  SUITE 200                  CHARLOTTE, NC                  (704) 556-1632</p>			
PROJECT NO: NG22			SCALE: 1"=200'
DATE: 07-27-99			DRAWN BY: TFB
CHECKED BY: CGB			DATE OF SURVEY: 07-21-99 TO 07-24-99
DRAWING NO: NG22-DET.DWG			SHT. 1 of 1

VICINITY MAP - NOT TO SCALE

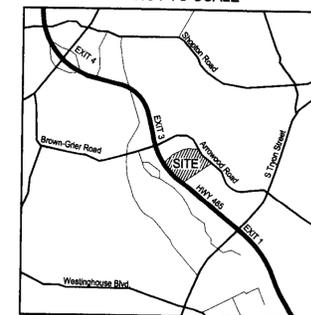

FEB 2 2009

FOR PUBLIC HEARING  
 PETITION NO. 2008-053


WHITEHALL CORPORATE CENTER - PHASE II  
 CHARLOTTE, NC

AMERICAN ASSET CORPORATION  
 BOUNDARY SURVEY

REVISIONS:  
 01/09/09 REVISIONS PER CITY COMMENTS

DATE: 01/25/2008  
 DRAWN BY: CGB  
 CHECKED BY: CGB  
 SCALE: 1"=200'-0"  
 PROJECT #: 1006065

SHEET #:  
**EX.1.0**

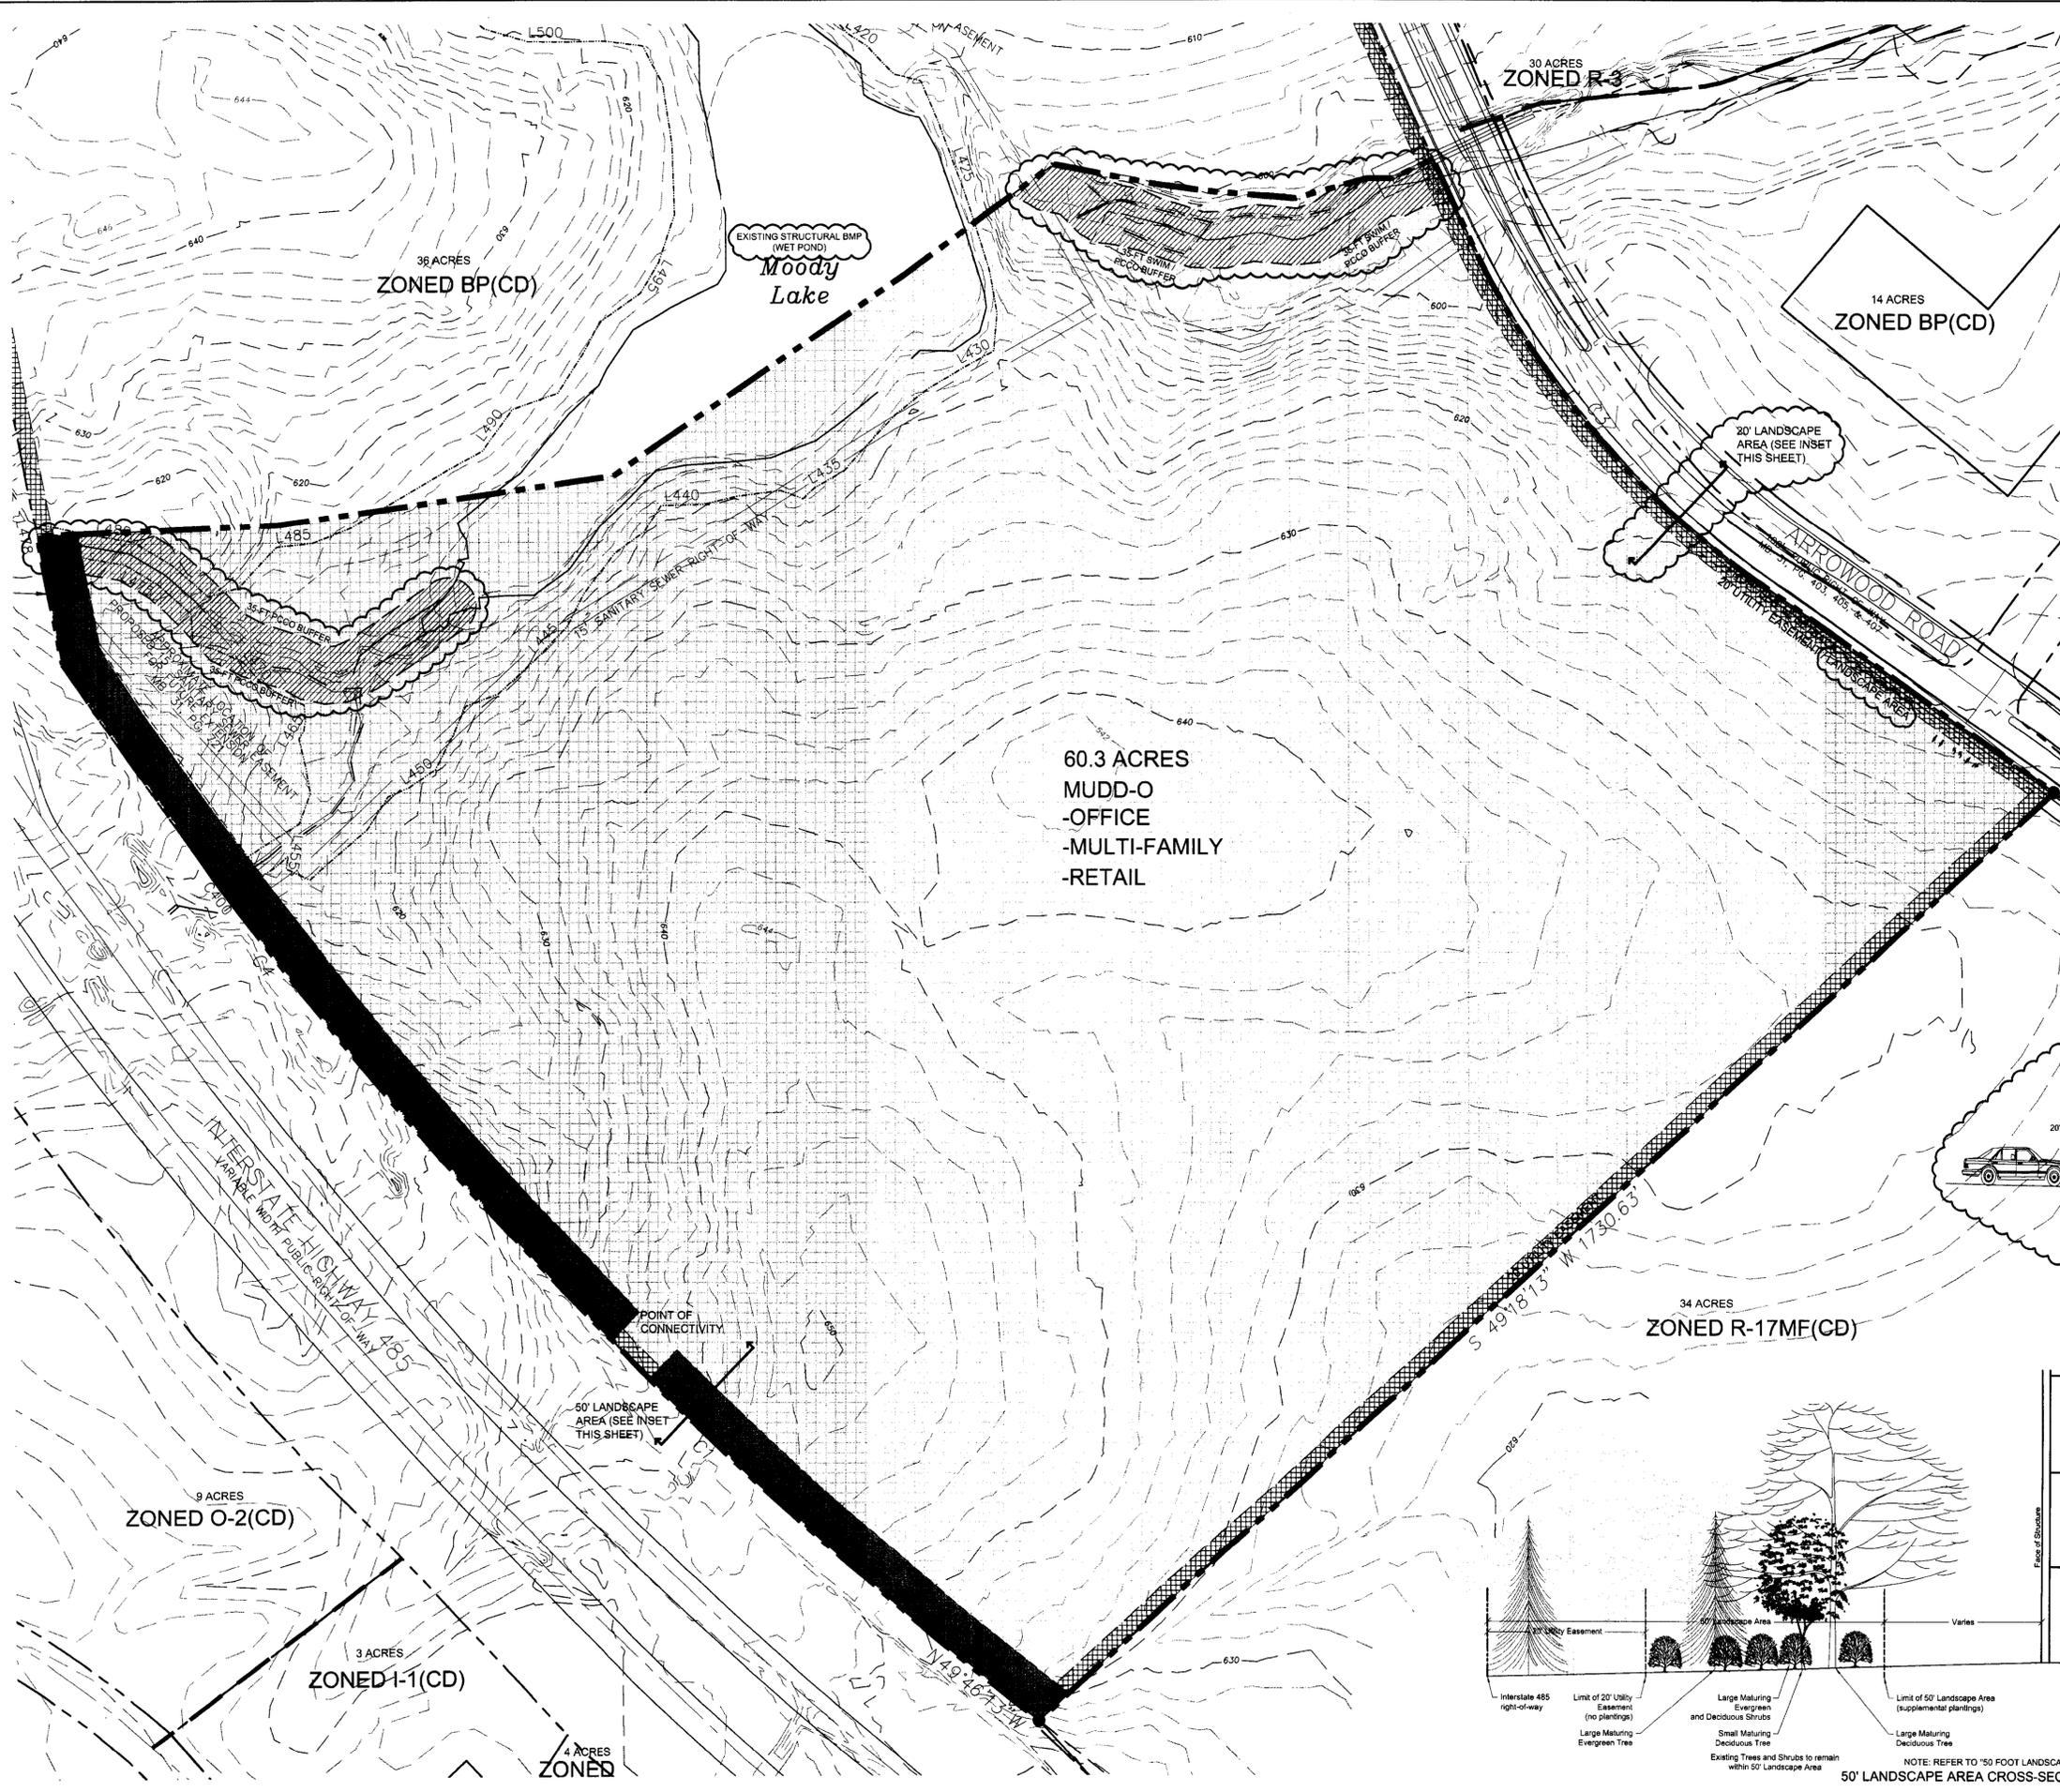

- SITE DEVELOPMENT SUMMARY:**
- TAX PARCEL ID #: A PORTION OF 201-451-05
  - DEVELOPMENT IS LOCATED WITHIN THE FOLLOWING DISTRICTS:  
SOUTHWEST DISTRICT
  - TOTAL SITE SF (ACREAGE): +/- 2,630,000 SF (60.3 AC)
  - EXISTING ZONING & USES:  
CONDITIONAL BUSINESS PARK - BP(CD)  
-VACANT
  - PROPOSED ZONING & PERMITTED USES:  
MIXED USE DEVELOPMENT DISTRICT (OPTIONAL) "MUDD-O"  
-OFFICE  
-MULTIFAMILY  
-RETAIL
  - DIMENSIONAL REQUIREMENTS:  
MINIMUM SETBACK REQUIREMENTS: 14 FEET FROM PROPOSED ROW  
MINIMUM SIDE YARD REQUIREMENTS: 0 FEET  
MINIMUM REAR YARD REQUIREMENTS: 0 FEET  
MAXIMUM BUILDING HEIGHT REQUIREMENTS: SEE DEVELOPMENT STANDARDS FOR MAXIMUM BUILDING HEIGHT

- PROPOSED OFFICE BUILDING SQUARE FOOTAGE:  
1,800,000 SQFT  
\*NOTE: REFER TO "PERMITTED USES" NOTE #2 ON TDS.1.2
- PROPOSED FREE STANDING RETAIL SQUARE FOOTAGE:  
40,000 SQFT (MAXIMUM)
- PROPOSED MULTI-FAMILY UNITS:  
400 UNITS MAXIMUM @ +/-1,500 SQFT/UNIT = 600,000 SQFT
- REQUIRED URBAN OPEN SPACE:  
24,400 SQFT MINIMUM
- PROVIDED URBAN OPEN SPACE:  
92,000 SQFT
- PROVIDED NATURAL AREA / TREE SAVE AREA:  
6.8 ACRES (11.3% OF TOTAL PROJECT SITE)





**PARKING REQUIREMENTS:**  
MINIMUM PARKING PER SECTION 9.8507 OF THE ORDINANCE

**GENERAL NOTES:**  
1. PROPERTY BOUNDARY SURVEY PROVIDED BY:  
ESP ASSOCIATES, P.A.  
10915 SOUTHERN LOOP BOULEVARD  
PINEVILLE, NC 28134  
704.583.4949




ADJACENT PARCEL INFORMATION & TREE COVER PROVIDED BY:  
2004 MECKLENBURG COUNTY DELD. DATA.

SEE SHEET TDS.2.3 FOR AIRPORT OVERLAY PLAN LEGEND:

PROJECT BOUNDARY:

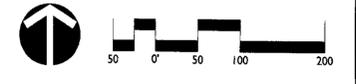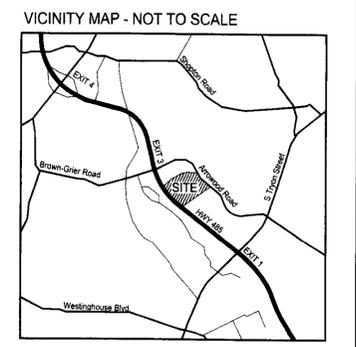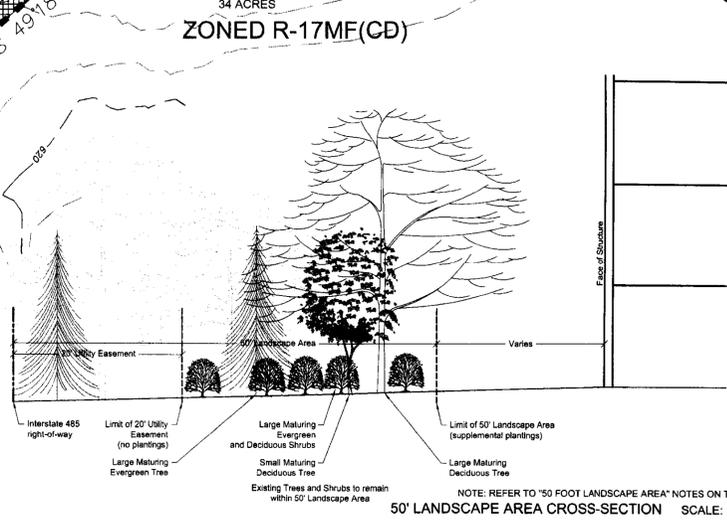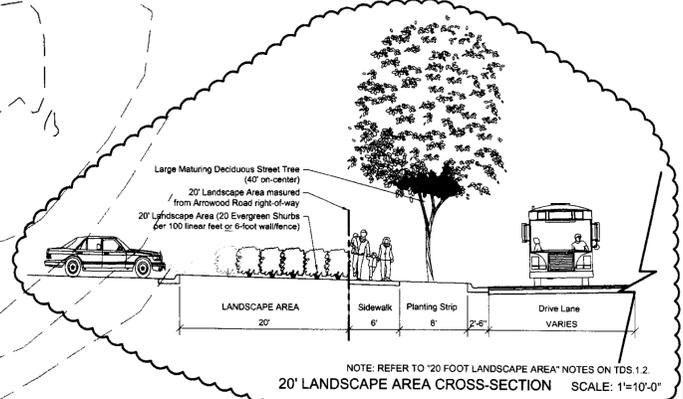

FOR PUBLIC HEARING  
PETITION NO. 2008-053

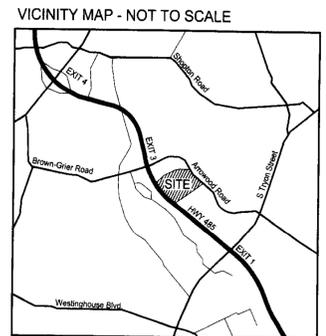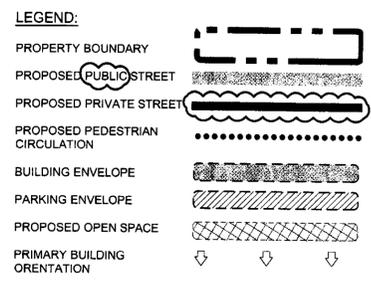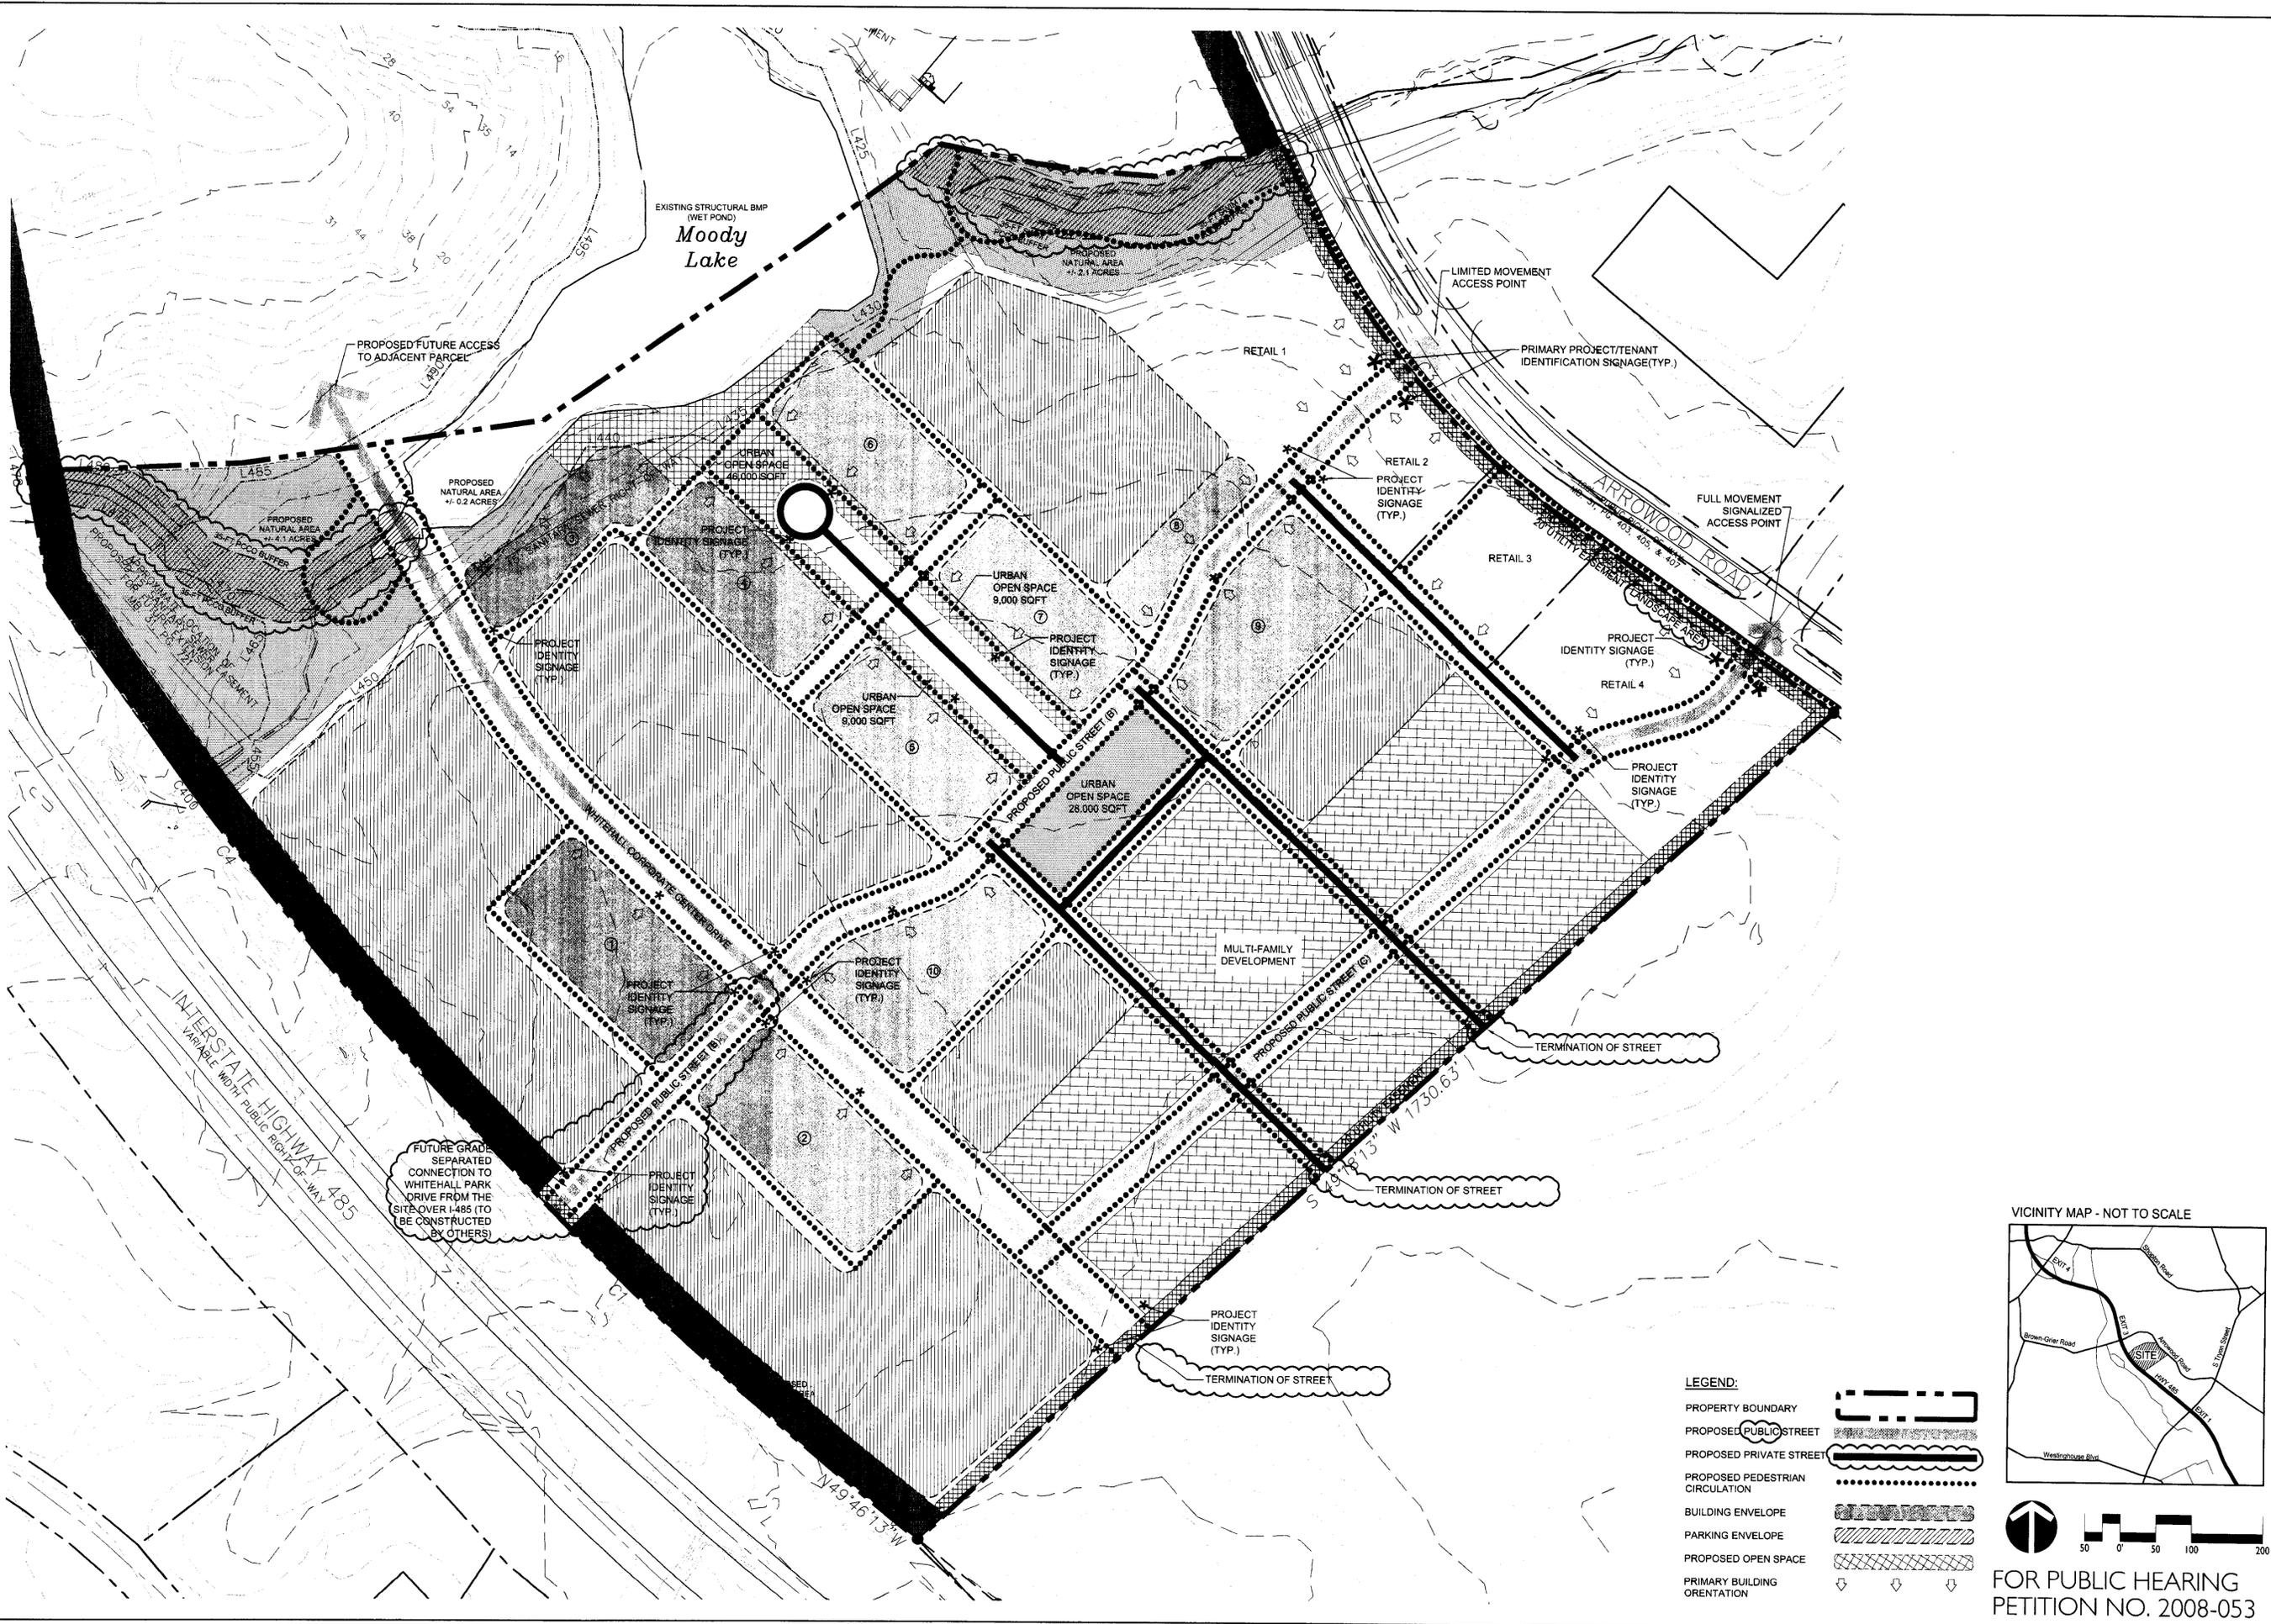

FOR PUBLIC HEARING  
 PETITION NO. 2008-053

**DEVELOPMENT GUIDELINES**

THE AMERICAN ASSET CORPORATION PROPERTY AT INTERSTATE HIGHWAY 485 / ARROWOOD ROAD

**WHITEHALL CORPORATE CENTER - PHASE 2 LEGAL DESCRIPTION**

THAT CERTAIN PARCEL OF LAND, SITUATED, LYING AND BEING IN THE CITY OF CHARLOTTE, MECKLENBURG COUNTY, NORTH CAROLINA, AND BEING MORE PARTICULARLY DESCRIBED AS FOLLOWS:

COMMENCING AT A EXISTING IRON ROD ON THE SOUTHWESTERN RIGHT OF WAY LINE OF ARROWOOD ROAD (100' PUBLIC RIGHT OF WAY) N 53°27'10" W A DISTANCE OF 378.56 FEET TO A NEW IRON ROD BEING THE POINT AND PLACE OF BEGINNING; THENCE WITH THE NORTHERN LINE OF DEXTER AND BERDIE YAGER FAMILY LIMITED PARTNERSHIP PROPERTY AS RECORDED IN DEED BOOK 11557, PAGE 316 IN THE MECKLENBURG COUNTY REGISTER OF DEEDS, THENCE WITH THE AFORESAID LINE S 49°17'40" W A DISTANCE OF 1,730.76 FEET TO AN EXISTING IRON ROD ON THE NORTHERN RIGHT OF WAY OF INTERSTATE 485, THENCE WITH THE AFORESAID RIGHT OF WAY THE FOLLOWING FOUR (4) COURSES AND DISTANCES: 1) N 49°45'45" W A DISTANCE OF 170.95 FEET TO AN EXISTING RIGHT OF WAY DISK, 2) THENCE WITH THE ARC OF A CIRCULAR CURVE TURNING TO THE RIGHT WITH A RADIUS OF 5,564.29 FEET, AND AN ARC LENGTH OF 739.88, (CHORD: N 45°08'34" W A DISTANCE OF 739.33 FEET), TO AN EXISTING RIGHT OF WAY DISK, 3) THENCE WITH THE ARC OF A CIRCULAR CURVE TURNING TO THE RIGHT WITH A RADIUS OF 5,564.29 FEET, AND AN ARC LENGTH OF 904.11, (CHORD: N 36°41'43" W A DISTANCE OF 903.11 FEET), TO AN EXISTING RIGHT OF WAY DISK, 4) THENCE N 09°30'43" W A DISTANCE OF 164.36 FEET TO A POINT, THENCE WITH A NEW LINE RUNNING THROUGH THE PROPERTY THE FOLLOWING EIGHT (8) COURSES AND DISTANCES: 1) THENCE N 89°07'20" E A DISTANCE OF 302.66 FEET TO A POINT, 2) THENCE N 83°18'37" E A DISTANCE OF 428.45 FEET TO A POINT, 3) THENCE N 57°30'42" E A DISTANCE OF 447.22 FEET TO A POINT, 4) THENCE N 55°29'51" E A DISTANCE OF 229.79 FEET TO A POINT, 5) THENCE S 77°24'50" E A DISTANCE OF 132.29 FEET TO A POINT, 6) THENCE S 81°04'24" E A DISTANCE OF 74.53 FEET TO A POINT, 7) THENCE S 83°40'19" E A DISTANCE OF 53.33 FEET TO A POINT, 8) THENCE N 81°11'21" E A DISTANCE OF 90.27 FEET TO A POINT, 9) THENCE S 88°33'47" E A DISTANCE OF 30.83 FEET TO A POINT, 10) THENCE N 86°40'13" E A DISTANCE OF 58.55 FEET TO A POINT ON THE SOUTHWESTERN RIGHT OF WAY LINE OF ARROWOOD ROAD, THENCE WITH THE AFORESAID RIGHT OF WAY THE FOLLOWING FOUR (4) COURSES AND DISTANCES: 1) S 23°25'46" E A DISTANCE OF 46.59 FEET TO A NEW IRON ROD, 2) THENCE S 23°25'46" E A DISTANCE OF 22.53 FEET TO AN EXISTING IRON ROD, 3) THENCE WITH THE ARC OF A CIRCULAR CURVE TURNING TO THE LEFT WITH A RADIUS OF 1,200.00 FEET, AND AN ARC LENGTH OF 628.81, (CHORD: S 38°26'28" E A DISTANCE OF 621.84 FEET), TO AN EXISTING IRON ROD, 4) THENCE S 53°27'10" E A DISTANCE OF 432.16 FEET TO THE POINT OF BEGINNING; CONTAINING 2,628.07 SQUARE FEET OR 60.3319 ACRES.

**GENERAL PROVISIONS**

- 1. THESE DEVELOPMENT STANDARDS FORM A PART OF THE TECHNICAL DATA SHEET (THE "TECHNICAL DATA SHEET") ASSOCIATED WITH THE REZONING PETITION FILED BY AMERICAN ASSET CORPORATION TO ACCOMMODATE THE DEVELOPMENT OF THE "WHITEHALL CORPORATE CENTER - PHASE II" PROJECT.
- 2. DEVELOPMENT OF THE PROPERTY IDENTIFIED ON THIS TECHNICAL DATA SHEET (HEREINAFTER THE "SITE") AND THE INDIVIDUAL COMPONENTS TO BE LOCATED THEREON WILL BE GOVERNED BY THE TECHNICAL DATA SHEET, THESE DEVELOPMENT STANDARDS, THE PLANS AND DRAWINGS EXPRESSLY INCORPORATED HEREIN BY REFERENCE AND THE APPLICABLE PROVISIONS OF THE CITY OF CHARLOTTE ZONING ORDINANCE (THE "ORDINANCE"). UNLESS MORE STRINGENT STANDARDS ARE ESTABLISHED BY THIS TECHNICAL DATA SHEET OR THESE DEVELOPMENT STANDARDS, AND SUBJECT TO THE OPTIONAL PROVISIONS SET OUT BELOW, ALL DEVELOPMENT STANDARDS ESTABLISHED UNDER THE ORDINANCE FOR THE MIXED USE DEVELOPMENT DISTRICT ("MUDD") ZONING DISTRICT SHALL BE FOLLOWED IN CONNECTION WITH DEVELOPMENT TAKING PLACE ON THE SITE.
- 3. THE DEVELOPMENT DEPICTED ON THE CONCEPTUAL SCHEMATIC SITE PLAN ATTACHED HERETO AS SHEET TDS. 2.0 (AND INCORPORATED HEREIN BY REFERENCE) IS SCHEMATIC IN NATURE AND IS INTENDED TO REFLECT THE ARRANGEMENT OF PROPOSED USES ON THE SITE AND TO ILLUSTRATE DESIGN PRINCIPALS. ACCORDINGLY, THE CONFIGURATION, PLACEMENT AND SIZE OF THE INDIVIDUAL SITE ELEMENTS AND BUILDING FOOTPRINTS OUTLINED ON THE CONCEPTUAL SCHEMATIC SITE PLAN ARE SCHEMATIC IN NATURE AND, SUBJECT ONLY TO THE PROVISIONS SET FORTH BELOW UNDER ARCHITECTURAL CONTROLS, MAY BE ALTERED OR MODIFIED DURING DESIGN, DEVELOPMENT AND CONSTRUCTION PHASES WITHIN THE MAXIMUM BUILDING/PARKING ENVELOPE LINES ESTABLISHED ON SHEET TDS.1.1. PARKING LAYOUTS MAY ALSO BE MODIFIED TO ACCOMMODATE FINAL BUILDING LOCATIONS AND OFF-STREET PARKING SPACES MAY BE LOCATED INSIDE AND OUTSIDE OF THE BUILDING ENVELOPE TO THE EXTENT PERMITTED BY THE ORDINANCE. ALL SUCH CHANGES ARE SUBJECT TO APPROVAL AS PROVIDED UNDER CHAPTER 6 OF THE ORDINANCE.

**PERMITTED USES**

- 1. THE SITE MAY BE DEVOTED TO ANY USE PERMITTED BY RIGHT OR UNDER PRESCRIBED CONDITIONS IN THE MUDD ZONING DISTRICT, AND TO ANY INCIDENTAL OR ACCESSORY USE IN CONNECTION THEREWITH WHICH IS PERMITTED IN THE MUDD ZONING DISTRICT.
- 2. NOTWITHSTANDING THE FOREGOING, RESTAURANTS WITH DRIVE-THRU WINDOWS OR SERVICE LANES SHALL NOT BE PERMITTED ON THE SITE, PROVIDED, HOWEVER THAT OTHER TYPES OF BUSINESSES LOCATED ON THE SITE MAY HAVE DRIVE-THRU WINDOWS OR SERVICE LANES AS AN ACCESSORY USE IN ACCORDANCE WITH THE REQUIREMENTS OF THE ORDINANCE. A MAXIMUM OF TWO SUCH BUSINESSES ON THE SITE MAY UTILIZE DRIVE-THRU WINDOWS OR SERVICE LANES.
- 3. ANY BUSINESS UTILIZING DRIVE-THRU WINDOWS OR SERVICE LANES MUST BE LOCATED IMMEDIATELY ADJACENT TO ARROWOOD ROAD AS GENERALLY DEPICTED ON THE CONCEPTUAL SCHEMATIC SITE PLAN. ALTHOUGH THE PROPOSED DRIVE-THRU WINDOWS OR SERVICE LANES ARE DEPICTED WITH THE NORTHERNMOST TWO BUILDINGS LOCATED ALONG ARROWOOD ROAD ON THE CONCEPTUAL SCHEMATIC SITE PLAN, THE PETITIONER MAY LOCATE THE DRIVE-THRU WINDOWS OR SERVICE LANES WITH ANY OF THE BUILDINGS LOCATED IMMEDIATELY ADJACENT TO ARROWOOD ROAD, SUBJECT, HOWEVER, TO THE LIMITATION THAT ONLY TWO BUSINESSES ON THE SITE MAY UTILIZE DRIVE-THRU WINDOWS OR SERVICE LANES.
- 4. AN OPTIONAL REQUEST TO ALLOW DRIVE-THRU WINDOWS OR SERVICE LANES ON THE SITE IS SET OUT BELOW UNDER "OPTIONAL PROVISIONS"

**MAXIMUM GROSS FLOOR AREA/MAXIMUM NUMBER OF RESIDENTIAL UNITS**

- 1. A MAXIMUM OF 1,800,000 SQUARE FEET OF GROSS FLOOR AREA DEVOTED TO OFFICE USES MAY BE DEVELOPED ON THE SITE. FOR PURPOSES OF THIS PARAGRAPH, "OFFICE USES" SHALL BE DEEMED TO INCLUDE PROFESSIONAL BUSINESS AND GENERAL OFFICES, BANKS AND OTHER FINANCIAL INSTITUTIONS, CLINICS, MEDICAL, DENTAL OPTICIANS AND DOCTORS OFFICES, GOVERNMENTAL OFFICES, POST OFFICES, SIMILAR OFFICE USES AND HOTELS. A MAXIMUM OF 50,000 SQUARE FEET OF GROUND FLOOR COMMERCIAL, RETAIL AND/OR RESTAURANT USES MAY BE LOCATED WITHIN THE OFFICE BUILDINGS DEVELOPED ON THE SITE (DEVOTED TO OFFICE USES) PROVIDED THAT THE GROSS FLOOR AREA OF ANY SUCH USES SHALL COUNT TOWARDS THE MAXIMUM OF 1,800,000 SQUARE FEET OF GROSS FLOOR AREA THAT MAY BE DEVOTED TO OFFICE USES.
- 2. A MAXIMUM OF 40,000 SQUARE FEET OF GROSS FLOOR AREA MAY BE DEVOTED TO FREE STANDING COMMERCIAL, RETAIL AND/OR RESTAURANT USES, AS WELL AS TO OTHER USES PERMITTED UNDER SECTION 9.850(2) OF THE ORDINANCE.
- 3. A MAXIMUM OF 400 MULTI-FAMILY DWELLING UNITS (APPROXIMATELY 600,000 SQUARE FEET) MAY BE DEVELOPED ON THE SITE AS DEPICTED ON THE TECHNICAL DATA SHEET. THESE MULTI-FAMILY DWELLING UNITS MAY BE RENTAL UNITS OR FOR SALE UNITS.
- 4. FOR PURPOSES OF THE GROSS FLOOR AREA LIMITATIONS SET OUT ABOVE, THE TERM "GROSS FLOOR AREA" SHALL MEAN AND REFER TO THE SUM OF THE GROSS HORIZONTAL AREAS OF EACH FLOOR OF A PRINCIPAL BUILDING, AND ANY ACCESSORY BUILDINGS OR STRUCTURES ON THE SITE, MEASURED FROM THE OUTSIDE OF THE EXTERIOR WALLS OR FROM THE CENTER LINE OF PARTY WALLS; PROVIDED, HOWEVER, THAT SUCH SIDE SHALL EXCLUDE ANY SURFACE PARKING FACILITIES OR RELATED ACCESS AREAS AND AREAS USED FOR BUILDING AND EQUIPMENT ACCESS (SUCH AS STAIRS, ELEVATOR SHAFTS AND MAINTENANCE CRAWL SPACES), AND PROVIDED, FURTHER, THAT AREAS DEVOTED TO OUTDOOR DINING AND SEATING SHALL NOT BE INCLUDED IN THE CALCULATION OF GROSS FLOOR AREA. ADDITIONALLY, STRUCTURED PARKING FACILITIES SHALL NOT BE INCLUDED IN THE TERM "GROSS FLOOR AREA" OR IN THE CALCULATION OF GROSS FLOOR AREA.

**20 FOOT LANDSCAPE AREA ALONG ARROWOOD ROAD**

A 20 FOOT LANDSCAPE AREA SHALL BE ESTABLISHED ON THOSE PORTIONS OF THE SITE'S FRONTAGE ALONG ARROWOOD ROAD THAT ARE MORE PARTICULARLY DEPICTED ON THE TECHNICAL DATA SHEET, AND SUCH LANDSCAPE AREA SHALL BE PLANTED AND MAINTAINED IN ACCORDANCE WITH THE CROSS SECTION SET OUT ON SHEET TDS.1.0. AN EXISTING 20 FOOT UTILITY EASEMENT IS LOCATED WITHIN THE AREA SUBJECT TO THE 20 FOOT LANDSCAPE AREA, AND THIS 20 FOOT UTILITY EASEMENT MAY BE LOCATED WITHIN THE 20 FOOT LANDSCAPE AREA. IF THE LANDSCAPE MATERIALS LOCATED WITHIN THE 20 FOOT LANDSCAPE AREA ARE REMOVED OR DESTROYED IN CONNECTION WITH THE UTILIZATION OF THE 20 FOOT UTILITY EASEMENT, THE PETITIONER SHALL REPLACE OR REPLANT THE LANDSCAPE MATERIALS TO THE STANDARDS OF THE CROSS SECTION SET OUT ON SHEET TDS.1.0.

**20 FOOT LANDSCAPE AREA ALONG ARROWOOD ROAD (CON'T)**

NOTWITHSTANDING PARAGRAPH 1 ABOVE AND AS MORE PARTICULARLY DEPICTED ON THE CONCEPTUAL SCHEMATIC SITE PLAN, IN THE EVENT THAT A BUILDING LOCATED ALONG THE SITE'S FRONTAGE ON ARROWOOD ROAD UTILIZES PARKING AND MANEUVERING AREAS BETWEEN SUCH BUILDING AND THE SETBACK, A 50 FOOT LANDSCAPE AREA SHALL BE ESTABLISHED BETWEEN THE PARKING AND MANEUVERING AREAS AND ARROWOOD ROAD. THIS 50 FOOT LANDSCAPE AREA SHALL BE PLANTED AND MAINTAINED ACCORDANCE WITH THE CROSS SECTION SET OUT ON SHEET TDS.1.0. AN EXISTING 20 FOOT UTILITY EASEMENT IS LOCATED WITHIN THE AREA SUBJECT TO THE 50 FOOT LANDSCAPE AREA, AND THIS 20 FOOT UTILITY EASEMENT MAY BE LOCATED WITHIN THE 50 FOOT LANDSCAPE AREA. IF THE LANDSCAPE MATERIALS LOCATED WITHIN THE 50 FOOT LANDSCAPE AREA ARE REMOVED OR DESTROYED IN CONNECTION WITH THE UTILIZATION OF THE 20 FOOT UTILITY EASEMENT, THE PETITIONER SHALL REPLACE OR REPLANT THE LANDSCAPE MATERIALS TO THE STANDARDS OF THE CROSS SECTION SET OUT ON SHEET TDS.1.0.

ALTHOUGH PARKING AND MANEUVERING AREAS LOCATED BETWEEN A BUILDING AND THE SETBACK AND THE RELATED 50 FOOT LANDSCAPE AREA ARE DEPICTED ON THE CONCEPTUAL SCHEMATIC SITE PLAN ONLY WITH RESPECT TO THE NORTHERNMOST BUILDING LOCATED ALONG THE SITE'S FRONTAGE ON ARROWOOD ROAD, PARKING AND MANEUVERING AREAS MAY BE LOCATED BETWEEN ANY BUILDING LOCATED ALONG THE SITE'S FRONTAGE ON ARROWOOD ROAD AND THE SETBACK PROVIDED THAT THE 50 FOOT LANDSCAPE AREA DESCRIBED ABOVE IS PROVIDED.

NO BUILDINGS, PARKING SPACES OR STORM WATER DETENTION FACILITIES MAY BE LOCATED WITHIN THE 20 FOOT LANDSCAPE AREA OR THE 50 FOOT LANDSCAPE AREA DESCRIBED ABOVE.

**50 FOOT LANDSCAPE AREA ALONG INTERSTATE 485 RIGHT-OF-WAY**

A 50 FOOT LANDSCAPE AREA SHALL BE ESTABLISHED ON THOSE PORTIONS OF THE SITE'S FRONTAGE ALONG INTERSTATE 485 THAT ARE MORE PARTICULARLY DEPICTED ON THE TECHNICAL DATA SHEET, AND SUCH LANDSCAPE AREA SHALL MEET THE TREE AND SHRUB REQUIREMENTS OF A CLASS B BUFFER. AN EXISTING 20 FOOT UTILITY EASEMENT IS LOCATED WITHIN THE AREA SUBJECT TO THE 50 FOOT LANDSCAPE AREA, AND THIS 20 FOOT UTILITY EASEMENT MAY BE LOCATED WITHIN THE 50 FOOT LANDSCAPE AREA. NO TREES AND SHRUBS SHALL BE REQUIRED TO BE INSTALLED WITHIN THE 20 FOOT UTILITY EASEMENT PROVIDED, HOWEVER, THAT THE 50 FOOT LANDSCAPE AREA OTHERWISE MEETS THE TREE AND SHRUB REQUIREMENTS OF A CLASS B BUFFER.

NO BUILDINGS, PARKING SPACES OR STORM WATER DETENTION FACILITIES MAY BE LOCATED WITHIN THE 50 FOOT LANDSCAPE AREA DESCRIBED ABOVE.

EXISTING TREES GREATER THAN 8 INCHES IN CALIPER AND SHRUBS GREATER THAN 36 INCHES IN HEIGHT LOCATED WITHIN THE 50 FOOT LANDSCAPE AREA BUT OUTSIDE OF THE EXISTING 20 FOOT UTILITY EASEMENT SHALL BE PRESERVED. EXISTING TREES AND SHRUBS SHALL BE CONSIDERED IN DETERMINING THE 50 FOOT LANDSCAPE AREA'S COMPLIANCE WITH THE TREE AND SHRUB REQUIREMENTS OF A CLASS B BUFFER.

**SETBACKS, SIDE YARDS AND REAR YARDS**

- 1. ALL BUILDINGS CONSTRUCTED WITHIN THE SITE SHALL SATISFY OR EXCEED THE SETBACK, REAR YARD AND SIDE YARD REQUIREMENTS ESTABLISHED UNDER THE ORDINANCE FOR THE MUDD ZONING DISTRICT.
- 2. ALL PUBLIC AND PRIVATE STREETS SHALL BE DESIGNED WITH A MINIMUM BUILDING AND PARKING SETBACK OF FOURTEEN (14) FEET.

**TREE ORDINANCE SCREENING AND LANDSCAPING AREAS**

- 1. DEVELOPMENT OF THE SITE WILL COMPLY WITH THE CITY OF CHARLOTTE TREE ORDINANCE.
- 2. LANDSCAPE AREAS WILL BE PLANTED ON THE SITE TO MEET OR EXCEED THE REQUIREMENTS OF THE ORDINANCE.
- 3. STREET TREES SHALL BE INSTALLED ALONG ALL PUBLIC AND PRIVATE STREETS PER SECTION 21-14(C)(3) OF THE CITY OF CHARLOTTE TREE ORDINANCE.
- 4. SCREENING SHALL CONFORM WITH THE STANDARDS AND TREATMENTS SPECIFIED IN THE ORDINANCE.
- 5. LANDSCAPE AREAS AND SETBACKS SHALL BE MAINTAINED BY THE OWNER OR OWNERS OF THE SITE.

**OPTIONAL PROVISIONS**

- 1. PURSUANT TO SECTIONS 9.8508 THROUGH 9.8512 OF THE ORDINANCE, THE PETITIONER REQUESTS THE APPROVAL OF THE FOLLOWING OPTIONAL PROVISIONS:
  - 1.a. THE PETITIONER REQUESTS A DEVIATION FROM SECTION 9.8509(5) OF THE ORDINANCE TO PERMIT THE MAXIMUM 12 STORY BUILDINGS AND THE MAXIMUM 8 STORY BUILDINGS TO BE LOCATED ON SITE TO EXCEED 120 FEET IN HEIGHT. THOSE BUILDINGS THAT MAY BE A MAXIMUM OF 12 STORIES IN HEIGHT AND A MAXIMUM OF 8 STORIES IN HEIGHT ARE MORE PARTICULARLY DESCRIBED IN NOTE 4 UNDER "ARCHITECTURAL CONTROLS." BUILDING HEIGHT SHALL BE MEASURED FROM THE AVERAGE GRADE ALONG EACH FACADE OF THE BUILDING TO THE ROOF FINISH OF THE HIGHEST STAIRS AND ROOF STRUCTURES FOR ELEVATORS, STAIRWAYS, TANKS AND EQUIPMENT, OR SIMILAR EQUIPMENT FOR THE OPERATION AND MAINTENANCE OF A BUILDING.
  - 1.b. THE PETITIONER REQUESTS A DEVIATION FROM SECTION 9.8504 OF THE ORDINANCE TO ALLOW THE USE OF SIGNAGE, BULLETIN BOARDS, KIOSKS AND SIMILAR STRUCTURES FOR COMMERCIAL AND OFFICE USES.
  - 1.c. THE PETITIONER REQUESTS A DEVIATION FROM SECTION 9.8506(2)(C)(1)(B)(1) OF THE ORDINANCE TO ALLOW FOR UNIQUE SIGNAGE SYSTEMS ON THE SITE. IN ADDITION TO THE SIGNAGE STANDARDS PERMITTED UNDER SECTION 9.8506(2)(C), THE PETITIONER SHALL BE ALLOWED TO CONSTRUCT TWO DETACHED, GROUND-MOUNTED PROJECT/TENANT IDENTIFICATION SIGNS IN THE LOCATIONS GENERALLY DEPICTED ON SHEET TDS.1.0. THE PRIMARY PROJECT/TENANT IDENTIFICATION SIGN LOCATED ALONG ARROWOOD ROAD MAY BE UP TO 18- FEET IN HEIGHT AND HAVE 216 SQUARE FEET IN SIGNAGE AREA PER SIDE FOR A DOUBLE SIDED ENTRANCE SIGN. ALL OTHER DETACHED PROJECT/TENANT IDENTIFICATION SIGNS SHALL BE LIMITED TO 7- FEET IN HEIGHT AND 60 SQUARE FEET IN SIGNAGE AREA PER SIDE. PROJECT/TENANT IDENTIFICATION SIGNS MAY NOT BE LOCATED WITHIN THE PUBLIC RIGHTS-OF-WAY OR SIGHT TRIANGLES.
  - 1.d. IN ADDITION TO THE SIGNAGE STANDARDS PERMITTED UNDER SECTION 9.8508(2)(C) OF THE ORDINANCE, THE PETITIONER SHALL BE ALLOWED TO CONSTRUCT ONE MONUMENT STYLE BUILDING IDENTIFICATION SIGN FOR EACH OF THE BUILDINGS PROPOSED TO BE DEVELOPED ON THE SITE. THESE SIGNS MUST BE LOCATED ALONG INTERIOR STREETS AND MAY BE UP TO 7- FEET IN HEIGHT AND HAVE UP TO 60 SQUARE FEET IN SIGNAGE AREA PER SIDE. IN ADDITION, WAY FINDING AND DIRECTIONAL SIGNS MAY BE PERMITTED IN ACCORDANCE WITH THE ORDINANCE REQUIREMENTS FOR THE MUDD ZONING DISTRICT. THIS SIGNAGE SHALL BE LOCATED OUTSIDE OF ALL REQUIRED SIGHT TRIANGLES.
  - 1.e. THE PETITIONER REQUESTS THAT DRIVE-THRU WINDOWS OR SERVICE LANES BE PERMITTED AS AN ACCESSORY USE TO BUSINESSES LOCATED ON THE SITE OTHER THAN A RESTAURANT AS PROVIDED ABOVE UNDER "PERMITTED USES".

THE PETITIONER REQUESTS A DEVIATION FROM SECTION 9.8507(2) OF THE ORDINANCE TO ALLOW OFF-STREET PARKING AND MANEUVERING AREAS TO BE LOCATED BETWEEN ANY BUILDING LOCATED ALONG THE SITE'S FRONTAGE ON ARROWOOD ROAD AND THE SETBACK, PROVIDED THAT THE 50 FOOT LANDSCAPE AREA DESCRIBED ABOVE IS PROVIDED.

**PARKING FACILITIES**

- 1. OFF STREET PARKING AND ON STREET PARKING SHALL MEET THE MINIMUM REQUIREMENTS OF THE ORDINANCE.
- 2. BIKE RACKS WILL BE PROVIDED PER THE ORDINANCE.
- 3. SHARED PARKING BETWEEN THE OFFICE AND MULTI-FAMILY USES SHALL BE ALLOWED PER ORDINANCE REQUIREMENTS.
- 4. THE STRUCTURED PARKING FACILITIES DEPICTED ON SHEET TDS.2.0 MAY BE SUBSTITUTED WITH SURFACE PARKING AREAS AT THE DISCRETION OF THE PETITIONER.
- 5. AS GENERALLY DEPICTED ON THE CONCEPTUAL SCHEMATIC SITE PLAN (SHEET TDS. 2.0), THE PETITIONER SHALL INSTALL ON A PORTION OF THE UPPER LEVEL OF EACH PARKING STRUCTURE LOCATED IMMEDIATELY ADJACENT TO THE INTERSTATE 485 RIGHT OF WAY A PRIVATE LANDSCAPE AREA THAT MAY, AT THE PETITIONER'S DISCRETION, BE UTILIZED FOR STORM WATER MANAGEMENT PURPOSES AND THAT WILL PROVIDE A VISUAL AMENITY FOR ADJACENT BUILDINGS. THESE PRIVATE LANDSCAPE AREAS MAY INCLUDE A VARIETY OF LANDSCAPE MATERIALS SUCH AS ORNAMENTAL GRASSES, OPEN LAWNS, SHRUBS AND TREES.

**TRANSPORTATION IMPROVEMENTS**

THE SITE DESCRIBED AND DEPICTED ON THE TECHNICAL DATA SHEET THAT IS SUBJECT TO THIS REZONING PETITION IS A 60.3 ACRE PORTION OF AN APPROXIMATELY 81.89 ACRE PARCEL OF LAND OWNED AND TO BE DEVELOPED BY THE PETITIONER, SUCH PARCEL OF LAND BEING HEREAFTER REFERRED TO AS THE "PETITIONER'S LARGE PARCEL" AND BEING MORE PARTICULARLY IDENTIFIED AS TAX PARCEL NO. 201-451-05 ON THE MECKLENBURG COUNTY TAX MAPS. ADJACENT TO THE PETITIONER'S LARGE PARCEL IS AN APPROXIMATELY 10.70 ACRE PARCEL OF LAND OWNED AND TO BE DEVELOPED BY THE PETITIONER, SUCH PARCEL OF LAND BEING HEREAFTER REFERRED TO AS THE "PETITIONER'S ADJACENT PARCEL" AND BEING MORE PARTICULARLY IDENTIFIED AS TAX PARCEL NO. 201-451-14 ON THE MECKLENBURG COUNTY TAX MAPS. FOR PURPOSES OF THE TRANSPORTATION IMPROVEMENT REQUIREMENTS SET OUT BELOW, THE PETITIONER'S LARGE PARCEL (WHICH INCLUDES THE SITE SUBJECT TO THIS REZONING PETITION) AND THE PETITIONER'S ADJACENT PARCEL ARE HEREAFTER COLLECTIVELY REFERRED TO AS THE "DEVELOPMENT SITE."

THAT PORTION OF THE PETITIONER'S LARGE PARCEL THAT IS NOT SUBJECT TO THIS REZONING PETITION AND THE PETITIONER'S ADJACENT PARCEL ARE ZONED BP (OD) AND THEY CAN BE DEVELOPED UNDER THE EXISTING ZONING WITH OFFICE, HOTEL AND LIMITED COMMERCIAL USES. AS A RESULT, IN THE EVENT THAT THE CHARLOTTE CITY COUNCIL APPROVES THIS REZONING PETITION, THE DEVELOPMENT SITE WILL BE DEVELOPED IN MULTIPLE PHASES OVER A PERIOD OF YEARS AS A SINGLE MIXED USE PROJECT CURRENTLY KNOWN AS WHITEHALL CORPORATE CENTER-PHASE II (THE "PROJECT").

THE TRANSPORTATION IMPROVEMENTS DESCRIBED BELOW ARE DESIGNED TO AND WILL MITIGATE THE TRAFFIC IMPACTS GENERATED BY THE PROJECT, AND THE PHASING REQUIREMENTS AND DENSITY THRESHOLDS FOR THE CONSTRUCTION AND INSTALLATION OF THE TRANSPORTATION IMPROVEMENTS SET OUT BELOW ARE BASED UPON THE DEVELOPMENT OF THE PROJECT ON THE ENTIRE DEVELOPMENT SITE.

THE TRANSPORTATION IMPROVEMENTS FOR THE PROJECT, AS DETERMINED BY A TRAFFIC IMPACT STUDY AND AGREED UPON BY THE PETITIONER AND THE CITY OF CHARLOTTE, WILL BE INCORPORATED INTO THE SITE DEVELOPMENT PROCESS AS THE VARIOUS PORTIONS OF THE DEVELOPMENT SITE ARE DEVELOPED.

- 5. AS SET FORTH BELOW, THE PROJECT SHALL BE DEVELOPED IN CERTAIN PHASES TIED TO THE COMPLETION OF CERTAIN TRANSPORTATION IMPROVEMENTS.
  - 5.1. PHASE IA - THE FOLLOWING RESIDENTIAL, GENERAL OFFICE AND SHOPPING CENTER USES ARE PERMITTED ON THE DEVELOPMENT SITE IN PHASE IA:
    - 400 MULTI-FAMILY DWELLING UNITS
    - 250,000 SQUARE FEET OF GENERAL OFFICE USES
    - 25,000 SQUARE FEET OF SHOPPING CENTER USES

THE FOLLOWING TRANSPORTATION IMPROVEMENTS SHALL BE COMPLETED PRIOR TO THE ISSUANCE OF A FINAL CERTIFICATE OF OCCUPANCY FOR THE 250,000 SQUARE FOOT OFFICE BUILDING TO BE LOCATED IN PHASE IA THAT WILL BE SERVED BY DRIVEWAY #3:

**ARROWOOD ROAD**

- CONSTRUCTION OF A WESTBOUND LEFT-TURN LANE ON ARROWOOD ROAD AT DRIVEWAY #3 WITH 150 FEET OF STORAGE
- CONSTRUCTION OF AN EASTBOUND RIGHT-TURN LANE ON ARROWOOD ROAD AT DRIVEWAY #3 WITH 150 FEET OF STORAGE

- 5.2. PHASE IB - THE FOLLOWING HOTEL AND GENERAL OFFICE USES ARE PERMITTED ON THE DEVELOPMENT SITE IN CONJUNCTION WITH THE CONSTRUCTION OF THE REQUIRED TRANSPORTATION IMPROVEMENTS FOR PHASE IB:
  - 300 HOTEL ROOMS
  - 250,000 SQUARE FEET OF GENERAL OFFICE USES

THE FOLLOWING TRANSPORTATION IMPROVEMENTS SHALL BE COMPLETED PRIOR TO THE ISSUANCE OF A FINAL CERTIFICATE OF OCCUPANCY FOR THE FIRST BUILDING IN PHASE IB:

**ARROWOOD ROAD**

- CONVERSION OF DRIVEWAY #3 TO A DIRECTIONAL CROSSOVER
- CONSTRUCTION OF AN ADDITIONAL WESTBOUND LEFT-TURN LANE ON ARROWOOD ROAD AT DRIVEWAY #1/WHITEHALL EXECUTIVE CENTER DRIVE WITH 150 FEET OF STORAGE
- INSTALLATION OF A TRAFFIC SIGNAL (WHEN WARRANTS ARE MET OR WHEN DIRECTED BY CDOT/NCDOT) AT THE DRIVEWAY #1/WHITEHALL EXECUTIVE CENTER DRIVE AT ARROWOOD ROAD INTERSECTION
- CONSTRUCTION OF DUAL EASTBOUND RIGHT-TURN LANES ON ARROWOOD ROAD AT DRIVEWAY #4 WITH 500 FEET OF STORAGE (1,000 TOTAL LANE-FEET), A RIGHT-TURN CHANNELIZING ISLAND, AND DUAL RECEIVING LANES ON DRIVEWAY #4 FOR THE INBOUND TRAFFIC (LENGTH TO BE DETERMINED DURING SUBDIVISION PLAN SUBMITTAL PROCESS)
- CONSTRUCTION OF AN EASTBOUND LEFT-TURN LANE ON ARROWOOD ROAD AT DRIVEWAY #4 WITH 150 FEET OF STORAGE
- CONSTRUCTION OF A SINGLE WESTBOUND LEFT-TURN LANE ON ARROWOOD ROAD AT DRIVEWAY #4 WITH 250 FEET OF STORAGE AND A PEDESTRIAN REFUGE MEDIAN
- INSTALLATION OF A TRAFFIC SIGNAL (WHEN WARRANTS ARE MET OR WHEN DIRECTED BY CDOT/NCDOT) AT THE DRIVEWAY #4/SHOPTON-ARROWOOD COLLECTOR ROAD (FUTURE) AT ARROWOOD ROAD INTERSECTION

**ADDITIONAL TRANSPORTATION IMPROVEMENTS FOR PHASE IB**

- CONSTRUCTION OF DUAL NORTHBOUND LEFT-TURN LANES ON DRIVEWAY #1 AT ARROWOOD ROAD WITH 175 FEET OF STORAGE (350 TOTAL LANE-FEET)
- CONSTRUCTION OF A NORTHBOUND THROUGH LANE ON DRIVEWAY #1 AT ARROWOOD ROAD
- CONSTRUCTION OF A NORTHBOUND RIGHT-TURN LANE ON DRIVEWAY #1 AT ARROWOOD ROAD WITH 150 FEET OF STORAGE
- CONSTRUCTION OF DUAL NORTHBOUND LEFT-TURN LANES ON DRIVEWAY #4 AT ARROWOOD ROAD WITH 800 FEET OF STORAGE (1,200 TOTAL LANE-FEET)
- CONSTRUCTION OF ONE NORTHBOUND THROUGH LANE AND ONE THROUGH/RIGHT-TURN LANE ON DRIVEWAY #4 AT ARROWOOD ROAD WITH 150 FEET OF STORAGE

- 5.3. PHASE IC - THE FOLLOWING GENERAL OFFICE USES ARE PERMITTED ON THE DEVELOPMENT SITE IN CONJUNCTION WITH THE CONSTRUCTION OF THE REQUIRED TRANSPORTATION IMPROVEMENTS FOR PHASE IC:
  - 600,000 SQUARE FEET OF GENERAL OFFICE USES

THE FOLLOWING TRANSPORTATION IMPROVEMENTS SHALL BE COMPLETED PRIOR TO THE ISSUANCE OF A FINAL CERTIFICATE OF OCCUPANCY FOR THE FIRST BUILDING IN PHASE IC:

**ARROWOOD ROAD**

- CONSTRUCTION OF AN ADDITIONAL SOUTHBOUND LEFT-TURN LANE ON I-485 OUTER LOOP RAMP AT ARROWOOD ROAD WITH 500 FEET OF STORAGE
- CONSTRUCTION OF AN ADDITIONAL NORTHBOUND LEFT-TURN LANE ON I-485 INNER LOOP RAMP AT ARROWOOD ROAD WITH 500 FEET OF STORAGE. TO ACCOMMODATE THE I-485 INNER LOOP RAMP IMPROVEMENTS IDENTIFIED IN PHASE IIB, 0.18-ACRES OF THE DEVELOPMENT SITE WILL BE DEDICATED BY THE PETITIONER FOR RIGHT-OF-WAY (MAXIMUM ENCROACHMENT OF 90 FEET INTO THE PROPERTY)
- CONSTRUCTION OF AN ADDITIONAL NORTHBOUND RIGHT-TURN LANE ON I-485 INNER LOOP RAMP AT ARROWOOD ROAD WITH 500 FEET OF STORAGE (1,000 TOTAL LANE-FEET)
- CONSTRUCTION OF A BI-DIRECTIONAL CROSSOVER ON ARROWOOD ROAD AT DRIVEWAY #2/ WHITEHALL EXECUTIVE CENTER DRIVE WITH 150' OF STORAGE
- CONSTRUCTION OF AN EASTBOUND RIGHT-TURN LANE ON ARROWOOD ROAD AT DRIVEWAY #2 WITH 150 FEET OF STORAGE
- COMPLETION OF THE INTERNAL SPINE ROAD CONNECTING DRIVEWAY #1 AND DRIVEWAY #4
- COMPLETION OF THE FUNCTIONAL DESIGN OF THE GRADE-SEPARATED CONNECTION FROM THE SITE OVER I-485 TO WHITEHALL PARK DRIVE. THE PURPOSE OF THE FUNCTIONAL DESIGN IS TO ESTABLISH THE HORIZONTAL AND VERTICAL ALIGNMENTS OF THE PROPOSED CONNECTION. STRUCTURAL DESIGN OF THE BRIDGE SUFFICIENT TO DETERMINE SUBSTRUCTURE AND SUPERSTRUCTURE THICKNESS, PROFILE GRADES, SLOPES/CUT-AND-FILL LIMITS, AND RIGHT-OF-WAY SHALL OCCUR PRIOR TO THE ISSUANCE OF A FINAL CERTIFICATE OF OCCUPANCY FOR THE FIRST BUILDING IN PHASE IC, AND SUCH PLANS SHALL BE SUBMITTED BY THE PETITIONER AS PART OF THE SUBDIVISION PROCESS. THE PETITIONER SHALL CONFER WITH CDOT, NCDOT, AND FHWA AS NECESSARY TO DETERMINE WHETHER STEEL, REINFORCED CONCRETE, OR ANOTHER MATERIAL SHALL BE USED FOR THE SUBSTRUCTURE PRIOR TO DEVELOPING THE FUNCTIONAL DESIGN PLANS. THE BRIDGE SHALL BE DESIGNED TO ACCOMMODATE THE FOLLOWING:
  - A. TWO 11-FOOT TRAVEL LANES
  - B. TWO 5-FOOT BIKE LANES
  - C. TWO 6-FOOT SIDEWALKS
  - D. CURB AND GUTTER
  - E. BRIDGE RAILS

**TRANSPORTATION IMPROVEMENTS (CON'T)**

- 5.3. PHASE IC (CON'T)
  - CONSTRUCT THE APPROACH (WHICH WILL BE PAVED) FOR THE FUTURE GRADE SEPARATED CONNECTION OVER I-485 FROM THE DEVELOPMENT SITE'S INTERNAL SPINE ROAD TO THE DRIVEWAYS INTO THE PARKING STRUCTURES TO BE LOCATED ON THE SITE ADJACENT TO I-485. FROM THAT POINT WEST, CONSTRUCT AN EARTHEN SLOPE TO BE TIED IN PRIOR TO THE CONTROL OF ACCESS LINE. THE PETITIONER WILL DEDICATE ALL NECESSARY RIGHT-OF-WAY, EASEMENTS, AND CONTROLLED ACCESS LIMITS ON THE SITE FOR THE FUTURE GRADE SEPARATED CONNECTION

IF ACTUAL COUNT VOLUMES AT THE PROJECT DRIVEWAYS AT THE COMPLETION OF PHASE I (AT A 100% OCCUPANCY LEVEL FOR PHASE I) ARE FOUND TO BE LESS THAN THOSE IDENTIFIED IN THE TRAFFIC IMPACT STUDY (1,479 FOR THE AM PEAK HOUR AND 1,884 FOR THE PM PEAK HOUR), THE PETITIONER RESERVES THE RIGHT TO CONSTRUCT AN ADDITIONAL AMOUNT OF GENERAL OFFICE USES, SHOPPING CENTER USES, HOTEL USES OR MULTI-FAMILY DWELLING UNITS WITHOUT HAVING TO CONSTRUCT ANY OTHER TRANSPORTATION IMPROVEMENTS BEYOND THOSE REQUIRED IN PHASE I ABOVE, PROVIDED THAT THE EXPECTED TRIP GENERATION BASED UPON THE ACTUAL COUNT DATA AT THE PROJECT DRIVEWAYS REMAINS LESS THAN THE VOLUMES IDENTIFIED ABOVE. IF PHASE I AT THE TIME OF THE COUNT IS NOT 100% OCCUPIED, THEN THE COUNTS WILL BE PROPORTIONALLY INCREASED TO REFLECT 100% OCCUPANCY.

- 5.4. PHASE IIA - THE FOLLOWING GENERAL OFFICE AND SHOPPING CENTER USES ARE PERMITTED ON THE DEVELOPMENT SITE IN CONJUNCTION WITH THE CONSTRUCTION OF THE REQUIRED TRANSPORTATION IMPROVEMENTS FOR PHASE IIA:
  - 600,000 SQUARE FEET OF GENERAL OFFICE USES
  - 15,000 SQUARE FEET OF SHOPPING CENTER USES

THE FOLLOWING TRANSPORTATION IMPROVEMENTS SHALL BE COMPLETED PRIOR TO THE ISSUANCE OF A FINAL CERTIFICATE OF OCCUPANCY FOR THE FIRST BUILDING IN PHASE IIA:

**STEELE CREEK ROAD**

- CONSTRUCTION OF A NORTHBOUND RIGHT-TURN LANE ON STEELE CREEK ROAD AT BROWN GRIER ROAD WITH 250 FEET OF STORAGE

**BROWN GRIER ROAD**

- CONSTRUCTION OF A WESTBOUND RIGHT-TURN LANE ON BROWN GRIER ROAD AT GALLANT LANE THAT EXTENDS BACK TO SANDY PORTER ROAD
- CONSTRUCTION OF AN EASTBOUND RIGHT-TURN LANE ON BROWN GRIER ROAD AT SANDY PORTER ROAD WITH 150 FEET OF STORAGE

- 5.5. PHASE IIB - THE FOLLOWING GENERAL OFFICE USES ARE PERMITTED ON THE DEVELOPMENT SITE IN CONJUNCTION WITH THE CONSTRUCTION OF THE REQUIRED TRANSPORTATION IMPROVEMENTS FOR PHASE IIB:
  - 435,000 SQUARE FEET OF GENERAL OFFICE USES

THE FOLLOWING TRANSPORTATION IMPROVEMENTS SHALL BE COMPLETED PRIOR TO THE ISSUANCE OF A FINAL CERTIFICATE OF OCCUPANCY FOR THE FIRST BUILDING IN PHASE IIB:

**ARROWOOD ROAD**

- RESTRIPIING OF ARROWOOD ROAD BETWEEN I-485 OUTER LOOP RAMP AND I-485 INNER LOOP RAMP TO PROVIDE DUAL WESTBOUND LEFT-TURN LANES ON ARROWOOD ROAD AT I-485 OUTER LOOP RAMP WITH 250 FEET OF STORAGE FOR THE INSIDE LANE AND THE OUTSIDE LANE EXTENDING BACK TO THE I-485 INNER LOOP RAMP INTERSECTION
- CONSTRUCTION OF A LOOP RAMP FROM EASTBOUND ARROWOOD ROAD TO I-485 INNER LOOP WITH 50 FEET OF STORAGE (THE RIGHT-TURN LANE AND TAPER TO BE DESIGNED AND CONSTRUCTED SUCH THAT THERE ARE NOT MODIFICATIONS TO THE ARROWOOD ROAD/I-485 INTERCHANGE BRIDGE)

**SOUTH TRYON STREET**

- CONSTRUCTION OF A WESTBOUND RIGHT-TURN LANE ON I-485 INNER LOOP RAMP AT S. TRYON STREET WITH 500 FEET OF STORAGE
- RESTRIPIING OF THE EXISTING WESTBOUND RIGHT-TURN LANE ON I-485 INNER LOOP RAMP AT S. TRYON STREET TO INCLUDE A SHARED LEFT/RIGHT-TURN LANE.

- 5.6. PHASE IIC - THE FOLLOWING GENERAL OFFICE USES ARE PERMITTED ON THE DEVELOPMENT SITE IN CONJUNCTION WITH THE CONSTRUCTION OF THE REQUIRED TRANSPORTATION IMPROVEMENTS FOR PHASE IIC:
  - 190,000 SQUARE FEET OF GENERAL OFFICE USES

THE FOLLOWING TRANSPORTATION IMPROVEMENTS SHALL BE COMPLETED PRIOR TO THE ISSUANCE OF A FINAL CERTIFICATE OF OCCUPANCY FOR THE FIRST BUILDING IN PHASE IIC:

**SOUTH TRYON STREET**

- CONSTRUCTION OF AN ADDITIONAL NORTHBOUND LEFT-TURN LANE ON S. TRYON STREET WITH 225 FEET OF STORAGE WITH THE ASSOCIATED 750-FOOT RECEIVING LANE ON WHITEHALL PARK DRIVE (AND 250-FOOT MERGE). THE LENGTH OF THE DRIVEWAY IS SUBJECT TO MODIFICATION IN ORDER TO ACCOMMODATE DRIVEWAY LOCATIONS AND WILL BE DETERMINED DURING THE PLAN REVIEW PROCESS.

**WHITEHALL PARK DRIVE**

- CONSTRUCTION OF A SINGLE EASTBOUND RIGHT-TURN LANE ON WHITEHALL PARK DRIVE AT S. TRYON STREET WITH 300 FEET OF STORAGE.

IF ACTUAL COUNT VOLUMES AT THE PROJECT DRIVEWAYS AT THE COMPLETION OF PHASE II (AT A 100% OCCUPANCY LEVEL FOR PHASE II) ARE FOUND TO BE LESS THAN THOSE IDENTIFIED IN THE TRAFFIC IMPACT STUDY (2,774 FOR THE AM PEAK HOUR AND 3,440 FOR THE PM PEAK HOUR), THE PETITIONER RESERVES THE RIGHT TO CONSTRUCT AN ADDITIONAL AMOUNT OF GENERAL OFFICE USES, SHOPPING CENTER USES, HOTEL USES OR MULTI-FAMILY DWELLING UNITS WITHOUT HAVING TO CONSTRUCT ANY OTHER TRANSPORTATION IMPROVEMENTS BEYOND THOSE REQUIRED IN PHASE II ABOVE, PROVIDED THAT THE EXPECTED TRIP GENERATION BASED UPON THE ACTUAL COUNT DATA AT THE PROJECT DRIVEWAYS REMAINS LESS THAN THE VOLUMES IDENTIFIED ABOVE. IF PHASE II AT THE TIME OF THE COUNT IS NOT 100% OCCUPIED, THEN THE COUNTS WILL BE PROPORTIONALLY INCREASED TO REFLECT 100% OCCUPANCY.

**DEVELOPMENT GUIDELINES**

THE AMERICAN ASSET CORPORATION PROPERTY AT INTERSTATE HIGHWAY 485 / ARROWOOD ROAD

**TRANSPORTATION IMPROVEMENTS (CONT)**

- THE PETITIONER SHALL EXERT REASONABLE AND GOOD FAITH EFFORTS TO OBTAIN FROM THE RELEVANT PROPERTY OWNERS, AT ITS SOLE COST AND EXPENSE, ANY RIGHT OF WAY NECESSARY TO CONSTRUCT AND INSTALL THE REQUIRED TRANSPORTATION IMPROVEMENTS DESCRIBED ABOVE. IN THE EVENT THAT THE PETITIONER IS UNABLE TO OBTAIN ANY OF THE REQUIRED RIGHT OF WAY AFTER EXERTING REASONABLE GOOD FAITH EFFORTS TO DO SO, THE CITY AND/OR CDOT SHALL OBTAIN THE REQUIRED RIGHT OF WAY BY PURCHASING THE SAME OR THROUGH EMINENT DOMAIN PROCEEDINGS. IN THE EVENT THAT THE CITY AND/OR CDOT PURCHASES ANY REQUIRED RIGHT OF WAY, THE PETITIONER SHALL REIMBURSE THE CITY AND/OR CDOT FOR THE PURCHASE PRICE AND ANY EXPENSES RELATED THERETO. IN THE EVENT THAT THE CITY AND/OR CDOT ACQUIRES ANY REQUIRED RIGHT OF WAY THROUGH EMINENT DOMAIN PROCEEDINGS, THE PETITIONER SHALL REIMBURSE THE CITY AND/OR CDOT FOR ANY AWARD OF JUST COMPENSATION AND/OR DAMAGES (AS DETERMINED THROUGH SETTLEMENT OR VERDICT), INCLUDING INTEREST, THAT THE CITY AND/OR CDOT IS REQUIRED TO PAY, AND FOR APPRAISAL FEES, ATTORNEY'S FEES AND OTHER COSTS AND EXPENSES INCURRED BY THE CITY AND/OR CDOT IN CONNECTION THEREWITH. THE PETITIONER SHALL NOT BE LIABLE, HOWEVER, FOR PAYMENTS THROUGH SETTLEMENT IN EXCESS OF APPRAISED VALUE UNLESS IT HAS GIVEN ITS PRIOR CONSENT.
- THE PETITIONER AGREES TO COMPLETE CONSTRUCTION AND PERMITTING DOCUMENTS (100% PLANS) FOR THE GRADE-SEPARATED CONNECTION FROM THE SITE OVER I-485 TO WHITEHALL PARK DRIVE AS GENERALLY DEPICTED ON THE TECHNICAL DATA SHEET WHEN FUNDING IS SECURED BY THE CITY OF CHARLOTTE FOR THIS IMPROVEMENT. THE PETITIONER IS NOT RESPONSIBLE FOR THE CONSTRUCTION COST ASSOCIATED WITH THIS WORK.
- TO ACCOMMODATE ADDITIONAL EASTBOUND LEFT-TURN STORAGE ON ARROWOOD ROAD AT S. TRYON STREET, THE PETITIONER SHALL PAY THE SUM OF \$100,000 TO CDOT TO BE USED AT CDOT'S DISCRETION FOR TRANSPORTATION IMPROVEMENTS AT/NEAR THE INTERSECTION OF S. TRYON STREET AND ARROWOOD ROAD. THIS PAYMENT SHALL BE PAID BY THE PETITIONER TO CDOT WITHIN FIVE (5) CALENDAR YEARS OF THE DATE ON WHICH THE FINAL CERTIFICATE OF OCCUPANCY WAS ISSUED FOR THE LAST BUILDING IN PHASE IIA.
- THE PETITIONER SHALL PAY THE SUM OF \$50,000 TO CDOT TO BE USED AT CDOT'S DISCRETION FOR TRANSPORTATION IMPROVEMENTS ALONG S. TRYON STREET NEAR WHITEHALL PARK DRIVE. THIS PAYMENT SHALL BE PAID BY THE PETITIONER TO CDOT WITHIN FIVE (5) CALENDAR YEARS OF THE DATE ON WHICH THE FINAL CERTIFICATE OF OCCUPANCY WAS ISSUED FOR THE LAST BUILDING IN PHASE IIC.
- IN LOCATIONS WHERE EXISTING CURB AND GUTTER IS BEING RELOCATED ON ARROWOOD ROAD, THE PETITIONER SHALL CONSTRUCT A 5-FOOT BIKE LANE. AS THIS BIKE LANE MAY BE DISCONTINUOUS, APPROPRIATE PAVEMENT MARKINGS SHALL BE DETERMINED BY CDOT AT THE TIME OF PLAN SUBMITTAL.
- PETITIONER SHALL BE RESPONSIBLE FOR THE FULL COST OF NEW TRAFFIC SIGNALS OR MODIFICATIONS TO EXISTING TRAFFIC SIGNALS. COSTS SHALL INCLUDE, BUT ARE NOT LIMITED TO, THE FOLLOWING:
  - SIGNAL POLES
  - CONTROLLER
  - DETECTION
  - INTERCONNECT CABLE/CONDUCT ALONG ARROWOOD ROAD FROM I-485 TO WHITEHALL EXECUTIVE CENTER DRIVE.
  - PEDESTRIAN SIGNALS
- IF AN INTERSECTION IS SIGNALIZED WITH MAST ARMS AND IMPROVEMENTS ARE NEEDED, THEN EXISTING MAST ARMS WILL BE MODIFIED OR NEW MAST ARMS WILL BE INSTALLED. HOWEVER, IF MAST ARMS CANNOT REASONABLY ACCOMMODATE THE SIZE OF THE INTERSECTION, STEEL STRAIN POLES WILL BE AN ACCEPTABLE SUBSTITUTE.

**LIGHTING**

- UNLESS STREET LIGHTING IS PROVIDED ALONG INTERNAL PRIVATE STREETS, PETITIONER AGREES TO INSTALL PEDESTRIAN SCALE LIGHTING ALONG INTERNAL PRIVATE STREETS, BUT MAY EXCLUDE PEDESTRIAN SCALE LIGHTING FROM RESIDENTIAL ALLEYS. THE MAXIMUM HEIGHT OF ANY FREESTANDING PEDESTRIAN SCALE LIGHTING FIXTURE, INCLUDING ITS BASE, SHALL NOT EXCEED 15 FEET.
- ALL DIRECT LIGHTING WITHIN THE SITE (EXCEPT STREET LIGHTS WHICH MAY BE ERECTED ALONG ARROWOOD ROAD) SHALL BE FULLY SHIELDED AND DESIGNED SUCH THAT DIRECT ILLUMINATION DOES NOT EXTEND PAST ANY EXTERIOR PROPERTY LINE OF THE SITE. CONSIDERATION WILL BE GIVEN TO THE IMPACT OF LIGHTING BOTH WITHIN AND OUTSIDE OF THE PERIMETER OF THE SITE. ITEMS FOR CONSIDERATION WILL INCLUDE INTENSITY, CUTOFF ANGLES, COLOR, ENERGY EFFICIENCY AND SHIELDING OF SOURCES OF LIGHT, THE INTENT BEING TO ELIMINATE GLARE TOWARDS ADJACENT PROPERTIES.
- NO WALL PACK LIGHT FIXTURES WILL BE ALLOWED ON ANY STRUCTURES PLACED ON THE SITE.

**SIGNS**

- EXCEPT AS PROVIDED UNDER "OPTIONAL PROVISIONS", ALL SIGNAGE INSTALLED ON THE SITE SHALL COMPLY WITH THE CITY OF CHARLOTTE SIGN ORDINANCE.
- SIGN LOCATIONS DEPICTED ON THE TECHNICAL DATA SHEET ARE APPROXIMATE LOCATIONS, AND SIGNS MAY BE RELOCATED TO OTHER LOCATIONS WITHIN THE SITE PROVIDED THAT THE LOCATION OF EACH SIGN COMPLIES WITH THE CITY OF CHARLOTTE SIGN ORDINANCE.
- TEMPORARY CONSTRUCTION SIGNAGE CANNOT BE LOCATED WITHIN THE REQUIRED SETBACK, AND MUST BE REMOVED NO LATER THAN 60 DAYS FOLLOWING THE RECEIPT OF THE CERTIFICATE OF OCCUPANCY FOR THE STRUCTURE ADDRESSED BY THE SIGNAGE.

**URBAN OPEN SPACE**

- IN THE URBAN OPEN SPACE AREAS TO BE LOCATED WITHIN THE SITE, THE PETITIONER SHALL CONSTRUCT OR INSTALL IMPROVEMENTS TO INCLUDE THE FOLLOWING ITEMS:
  - A. LARGE AND/OR SMALL MATURING TREES
  - B. LANDSCAPE AREAS
  - C. COURTYARDS
  - D. BENCHES
  - E. SIDEWALKS AND/OR PATHWAYS
  - F. PEDESTRIAN LIGHTING
  - G. SPECIALTY PAVING MATERIALS
- IN THE URBAN OPEN SPACE AREAS TO BE LOCATED WITHIN THE SITE, THE PETITIONER MAY, AT ITS DISCRETION, CONSTRUCT OR INSTALL IMPROVEMENTS SUCH AS THE FOLLOWING:
  - H. WATER FEATURES
  - I. OUTDOOR DINING AREAS
  - J. UNIQUE LIGHTING CONCEPTS
  - K. TERRACED PLAZAS AND/OR PATIOS
  - L. ACCESSORY STRUCTURES (KIOSKS, VENDORS, ETC.)
  - M. ART/SCULPTURES
- ADDITIONALLY, THE PETITIONER, AT ITS DISCRETION, MAY HOLD COMMUNITY EVENTS IN THE URBAN OPEN SPACE AREAS.

**ARCHITECTURAL CONTROLS**

- ALL OFFICE BUILDINGS CONSTRUCTED ON THE SITE SHALL BE ARCHITECTURALLY COMPATIBLE IN APPEARANCE THROUGH THE USE OF SIMILAR, AS WELL AS COMPLEMENTARY BUILDING MATERIALS, COLORS AND DESIGN (GIVING DUE CONSIDERATION TO THE USE OF EACH BUILDING).
- THE FIRST FLOOR OF ALL BUILDINGS SHALL BE DESIGNED TO ENCOURAGE AND COMPLEMENT PEDESTRIAN SCALE INTEREST AND ACTIVITY.
- BUILDING ELEVATIONS FOR EACH BUILDING TO BE DEVELOPED ON THE SITE SHALL BE SUBMITTED FOR REVIEW AND APPROVAL TO THE CHARLOTTE-MECKLENBURG PLANNING COMMISSION DURING THE SITE PLAN APPROVAL PROCESS PRIOR TO THE ISSUANCE OF BUILDING PERMITS FOR EACH BUILDING. PRIOR TO THE ISSUANCE OF BUILDING PERMITS FOR EACH BUILDING, THE CHARLOTTE-MECKLENBURG PLANNING COMMISSION SHALL HAVE THE OPPORTUNITY TO REVIEW THE PROPOSED ELEVATIONS AND THE APPROVED CONDITIONAL PLANS TO ASSURE COMPLIANCE WITH THE DESIGN PRINCIPALS ILLUSTRATED ON THE PLANS.
- THE HEIGHT OF THE BUILDINGS TO BE LOCATED WITHIN THE SITE SHALL BE LIMITED AS FOLLOWS:
  - TWO OF THE BUILDINGS WITHIN THE SITE TO BE DEVOTED TO OFFICE USES MAY HAVE A MAXIMUM HEIGHT OF 12 STORIES AND SIX OF THE BUILDINGS WITHIN THE SITE TO BE DEVOTED TO OFFICE USES MAY HAVE A MAXIMUM HEIGHT OF 8 STORIES.
  - THE BUILDINGS WITHIN THE SITE LOCATED IMMEDIATELY ADJACENT TO THE MULTI-FAMILY RESIDENTIAL DEVELOPMENT MAY HAVE A MAXIMUM HEIGHT OF 5 STORIES.
  - THE BUILDINGS WITHIN THE SITE LOCATED IMMEDIATELY ADJACENT TO ARROWOOD ROAD MAY HAVE A MAXIMUM HEIGHT OF 5 STORIES.

**SOLID WASTE**

- THE PETITIONER SHALL SUBMIT A SOLID WASTE MANAGEMENT PLAN TO MECKLENBURG COUNTY PRIOR TO INITIATING LAND CLEARING AND/OR CONSTRUCTION ACTIVITIES ON THE SITE. THE SOLID WASTE MANAGEMENT PLAN SHALL INCLUDE, AT A MINIMUM, THE PROCEDURES THAT WILL BE USED TO RECYCLE ALL CLEAN WOOD, METAL, AND CONCRETE GENERATED DURING DEMOLITION AND CONSTRUCTION ACTIVITIES, AND THE PLAN WILL SPECIFY THAT ALL LAND CLEARING AND INERT DEBRIS SHALL BE TAKEN TO A PROPERLY PERMITTED FACILITY. THE PLAN SHALL ALSO STATE THAT MONTHLY REPORTING OF ALL TONNAGE DISPOSED AND RECYCLED WILL BE MADE TO THE MECKLENBURG COUNTY SOLID WASTE PROGRAM. THE REPORT SHALL INCLUDE THE IDENTIFICATION AND LOCATION OF ALL FACILITIES RECEIVING DISPOSED OR RECYCLED MATERIALS.
- OFFICE, RETAIL, AND MULTI-FAMILY COMPLEXES MUST MEET ALL REQUIREMENTS AS STATED IN THE CHARLOTTE CITY CODE REGARDING SOLID WASTE DUMPSTER, COMPACTOR AND RECYCLING AREAS.

**FIRE PROTECTION**

- ALL NEW BUILDINGS SHALL COMPLY WITH THE LAND USE REQUIREMENTS OF THE CHARLOTTE FIRE DEPARTMENT.
- ALL NEW BUILDINGS SHALL COMPLY WITH THE WATER SUPPLY REQUIREMENTS OF THE CHARLOTTE FIRE DEPARTMENT.
- ALL NEW BUILDINGS SHALL COMPLY WITH THE ACCESS REQUIREMENTS OF THE NORTH CAROLINA STATE FIRE CODE AND THE CHARLOTTE FIRE DEPARTMENT.

**INTERNAL SIDEWALKS AND PRIVATE STREETS**

- INTERNAL SIDEWALKS AND PRIVATE STREETS SHALL BE DESIGNED TO MEET THE STANDARDS OF THE CITY OF CHARLOTTE URBAN STREET DESIGN GUIDELINES ADOPTED OCTOBER 22, 2007.
- AS CONCEPTUALLY DEPICTED ON THE CONCEPTUAL SCHEMATIC SITE PLAN, THE PETITIONER SHALL INSTALL INTERNAL SIDEWALKS ON THE SITE THAT WILL PROVIDE PEDESTRIAN CONNECTIONS BETWEEN OFFICE BUILDINGS AND FROM BUILDINGS TO SIDEWALKS ALONG STREETS WITHIN THE DEVELOPMENT.

**FIVE YEAR VESTED RIGHT**


- PURSUANT TO SECTION 1.110 OF THE ORDINANCE, A 5 YEAR VESTED RIGHT IS GRANTED FOR THE DEVELOPMENT PROJECT APPROVED UNDER THIS REZONING PETITION DUE TO THE SIZE AND PHASING OF THE DEVELOPMENT, THE LEVEL OF INVESTMENT, ECONOMIC CYCLES AND MARKET CONDITIONS.

**AMENDMENTS TO REZONING PLAN**

- FUTURE AMENDMENTS TO THE TECHNICAL DATA SHEET, THESE DEVELOPMENT STANDARDS AND THE CONCEPTUAL SCHEMATIC SITE PLAN MAY BE APPLIED FOR BY THE OWNER OR OWNERS OF THE SITE IN ACCORDANCE WITH SECTION 6.206 OF THE ORDINANCE.



**BINDING EFFECT OF THE REZONING APPLICATION**

- IF THE PETITIONER'S REZONING PETITION IS APPROVED, THE DEVELOPMENT PROGRAM ESTABLISHED UNDER THE TECHNICAL DATA SHEET AND OTHER SUPPORTIVE DOCUMENTS SHALL, UNLESS AMENDED IN THE MANNER PROVIDED UNDER THE ORDINANCE, BE BINDING UPON AND INURE TO THE BENEFIT OF THE PETITIONER AND THE CURRENT AND SUBSEQUENT OWNERS OF THE SITE AND THEIR RESPECTIVE HEIRS, DEVISEES, PERSONAL REPRESENTATIVES, SUCCESSORS IN INTERESTS AND ASSIGNS.
- THROUGHOUT THESE DEVELOPMENT STANDARDS, THE TERM "PETITIONER" OR "OWNER", SHALL BE DEEMED TO INCLUDE THE HEIRS, DEVISEES, PERSONAL REPRESENTATIVES, SUCCESSORS IN INTEREST AND ASSIGNS OF THE PETITIONER AND OWNER.

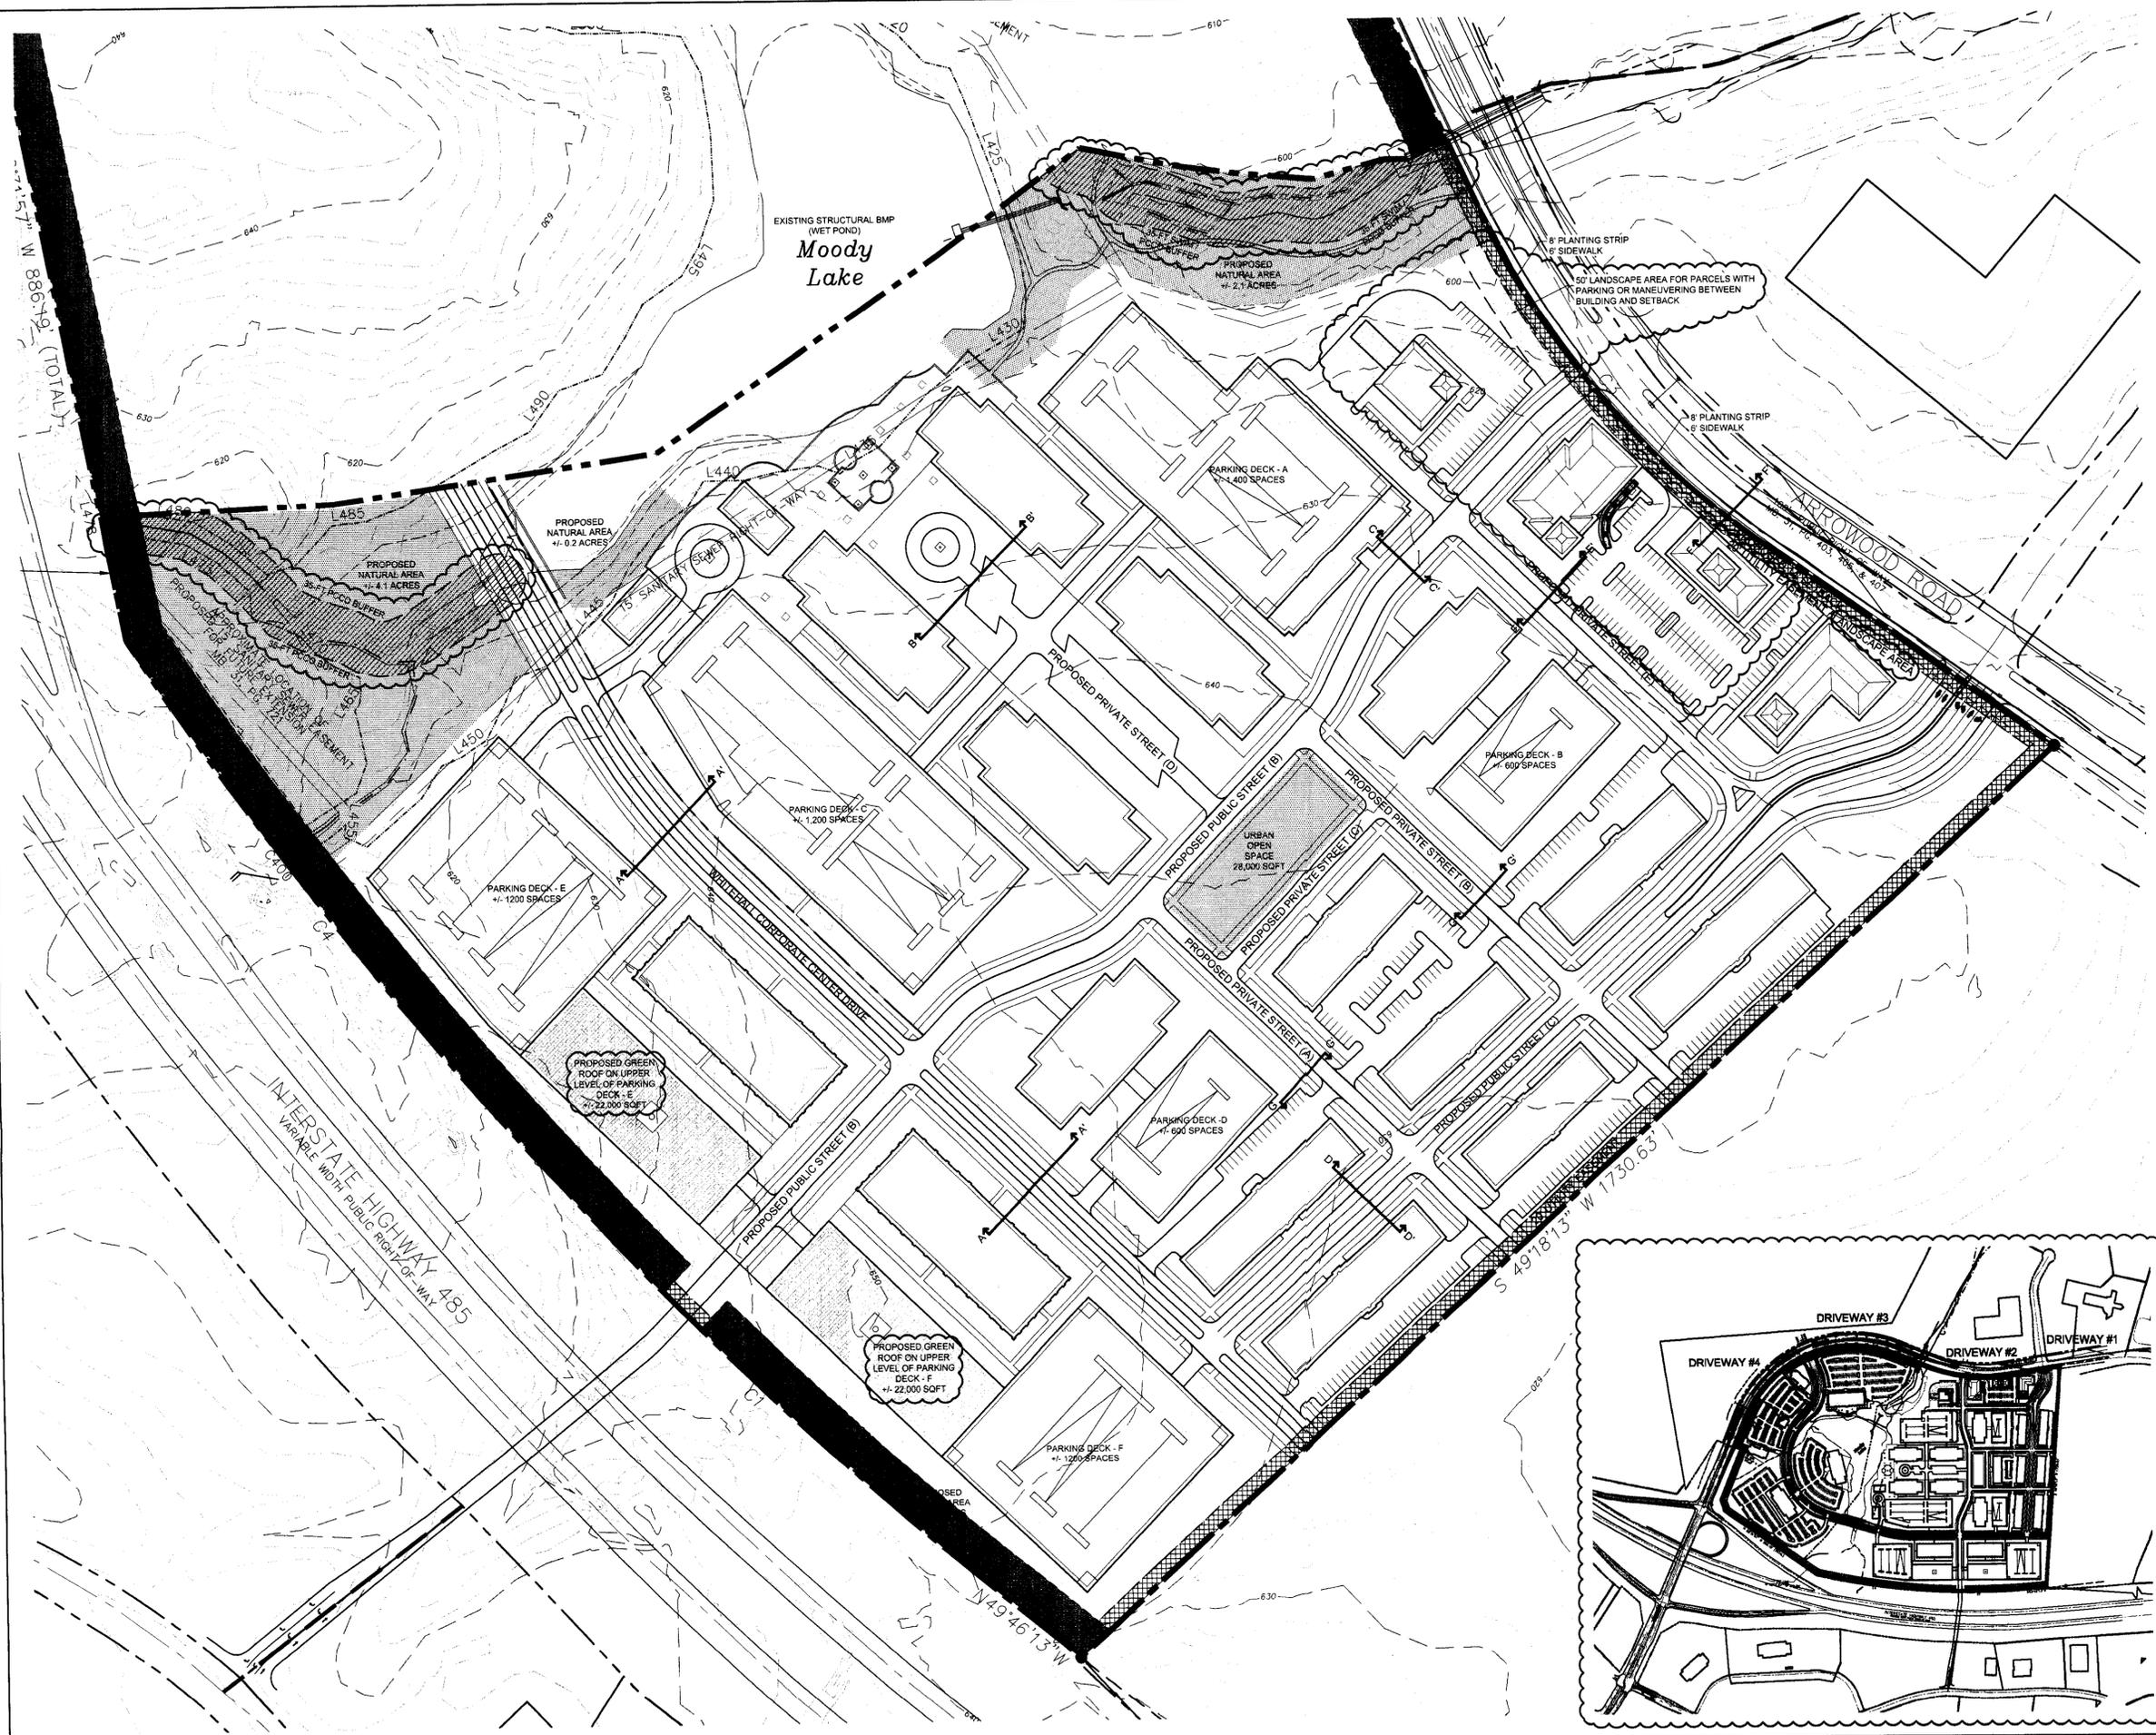


NOTE: THE ILLUSTRATIVE SITE PLAN IS SCHEMATIC IN NATURE AND IS INTENDED TO DEPICT BUILDING, PARKING AND CIRCULATION RELATIONSHIPS.


VICINITY MAP - NOT TO SCALE

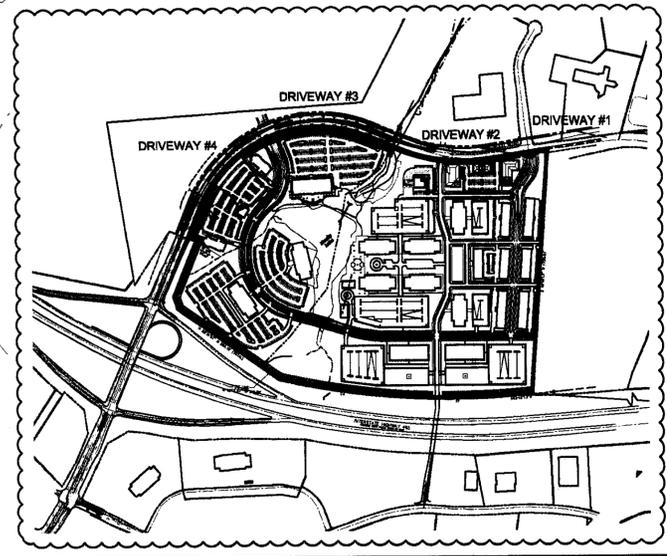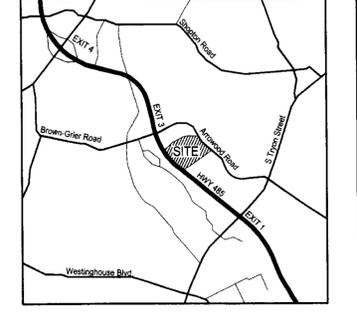


FOR PUBLIC HEARING  
PETITION NO. 2008-053

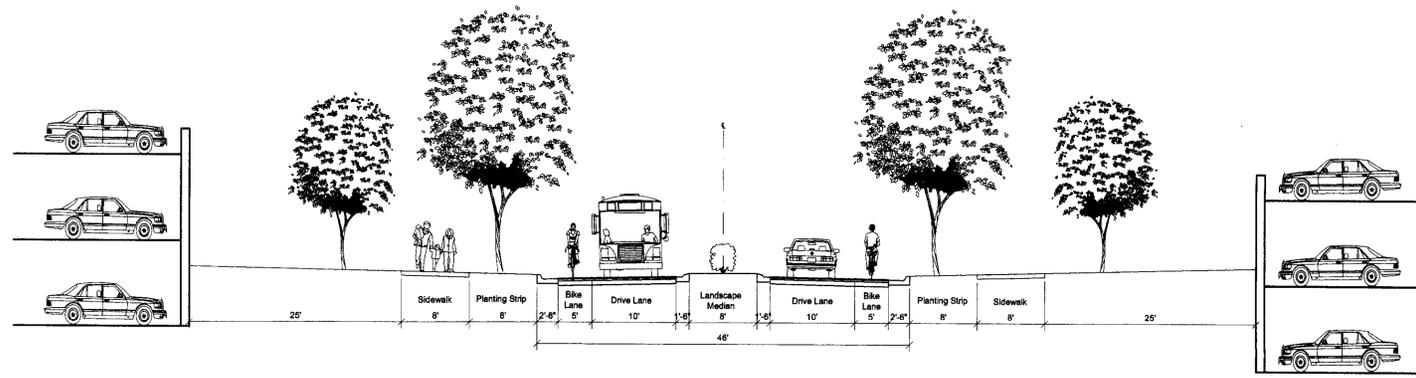


WHITEHALL CORPORATE CENTER DRIVE  
A - A' Cross-Section

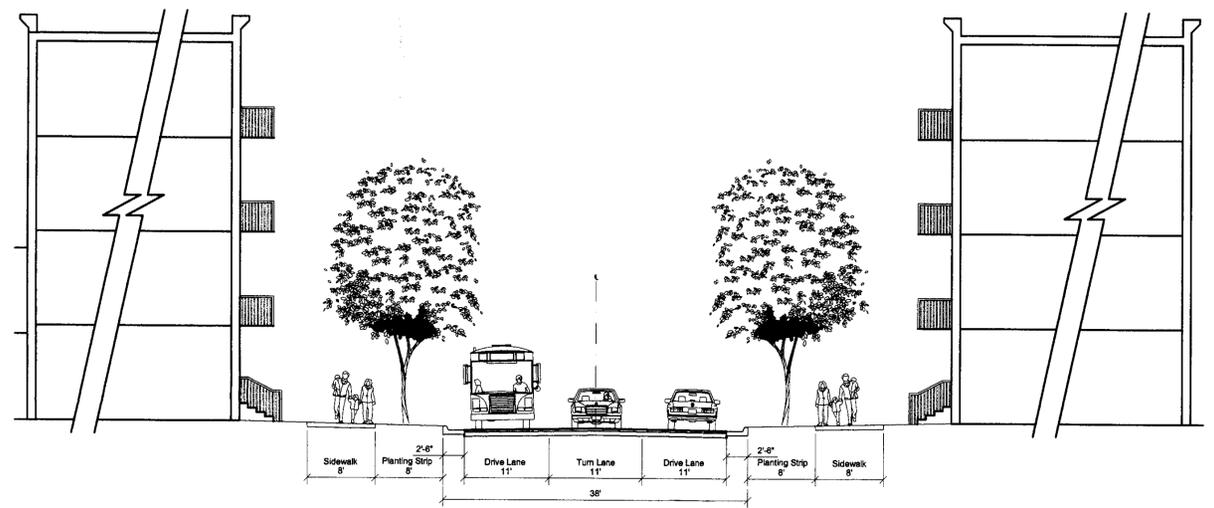


PROPOSED PUBLIC STREET (C)  
D - D' Cross-Section

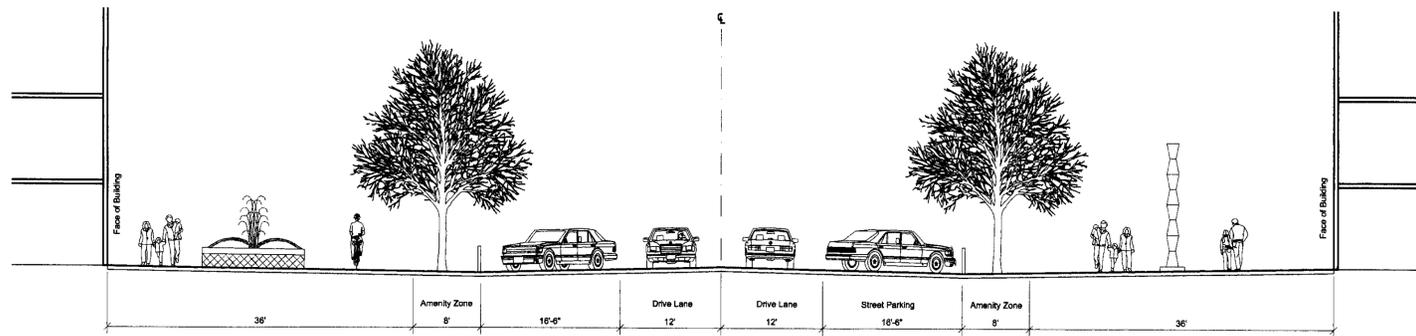

PROPOSED PRIVATE STREET (D)  
B - B' Cross-Section

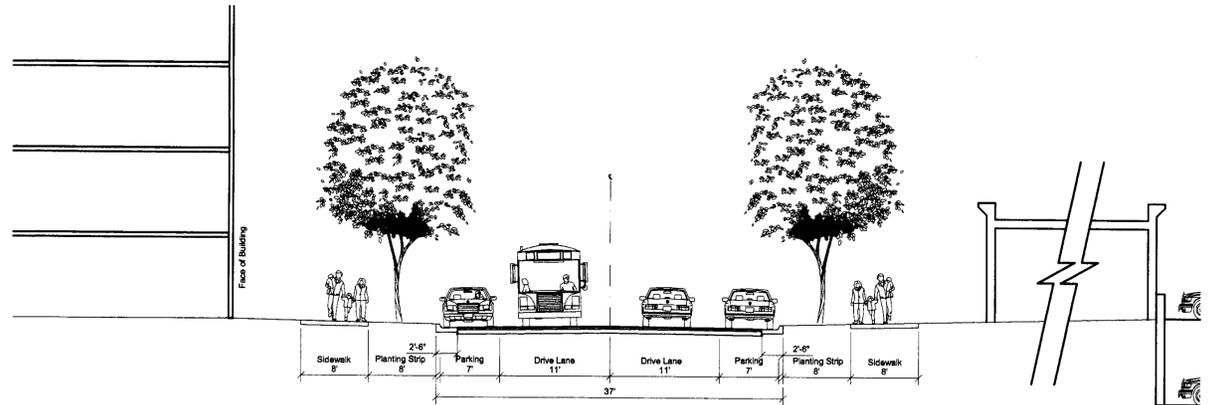


PROPOSED PRIVATE STREET (E)  
E - E' Cross-Section

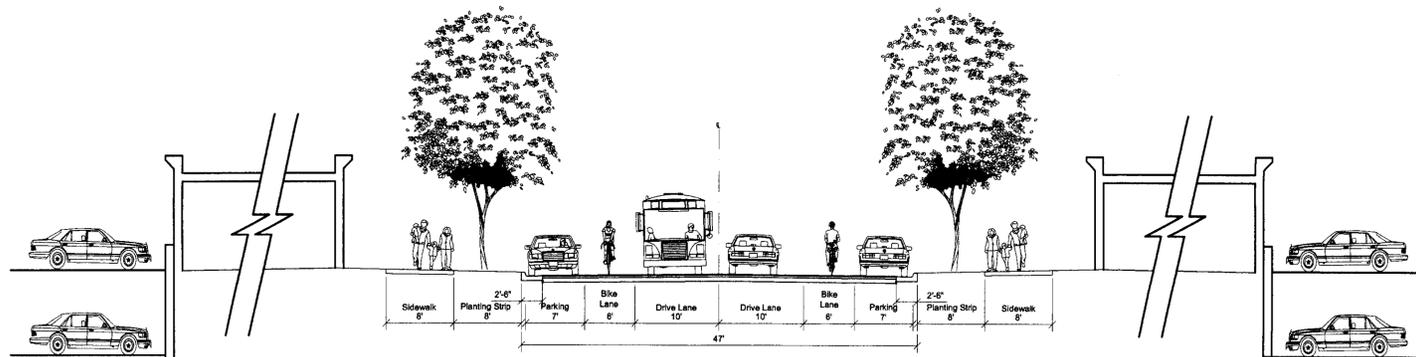


PROPOSED PUBLIC STREET (B)  
C - C' Cross-Section

NOTE:  
1. THE ILLUSTRATIVE SECTIONS ARE SCHEMATIC IN NATURE AND IS INTENDED TO DEPICT BUILDING, PARKING AND CIRCULATION RELATIONSHIPS.  
2. PROPOSED STREET CROSS SECTION WIDTHS ARE DESIGNED TO MEET THE CITY OF CHARLOTTE URBAN STREET DESIGN GUIDELINES ADOPTED OCTOBER 22, 2007.


VICINITY MAP - NOT TO SCALE

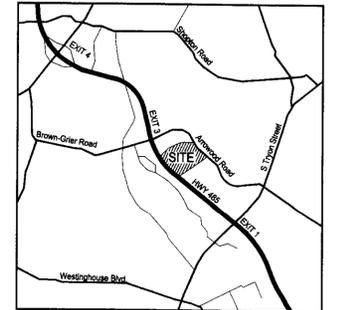

FOR PUBLIC HEARING  
PETITION NO. 2008-053

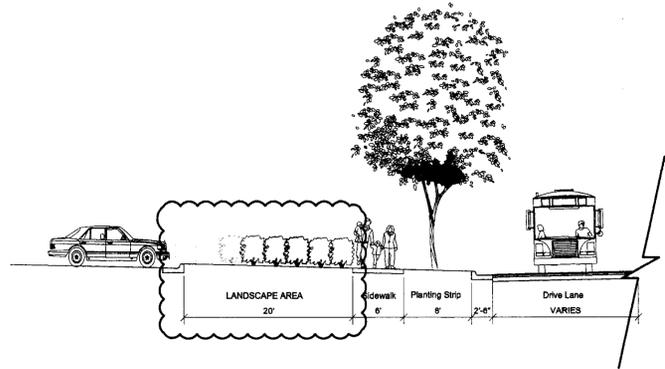


ARROWOOD ROAD  
F - F' Cross-Section

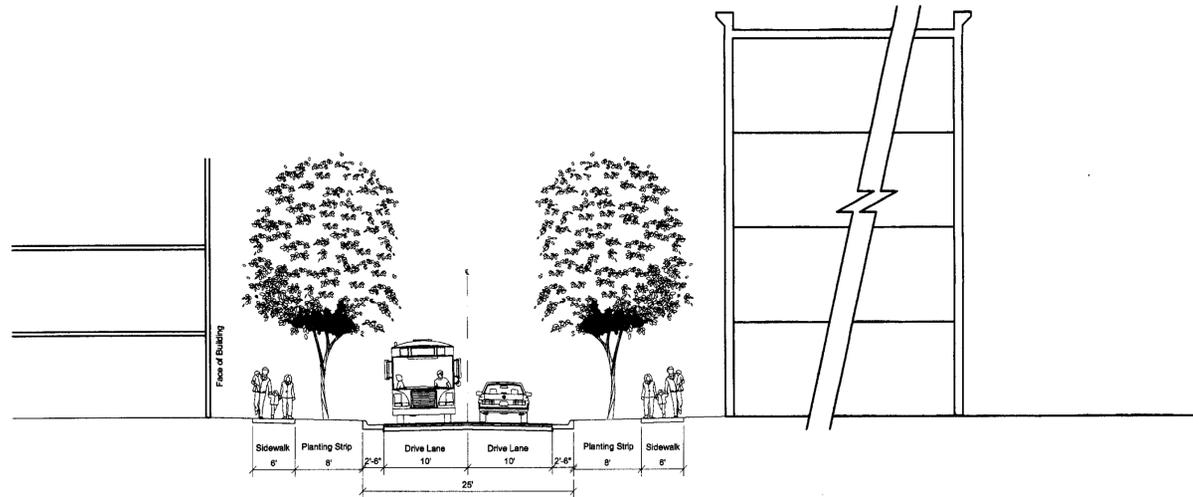


PROPOSED PRIVATE STREET (A) AND (B)  
G - G' Cross-Section


- NOTE:**
1. THE ILLUSTRATIVE SECTIONS ARE SCHEMATIC IN NATURE AND IS INTENDED TO DEPICT BUILDING, PARKING AND CIRCULATION RELATIONSHIPS.
  2. PROPOSED STREET CROSS SECTION WIDTHS ARE DESIGNED TO MEET THE CITY OF CHARLOTTE URBAN STREET DESIGN GUIDELINES ADOPTED OCTOBER 22, 2007.

VICINITY MAP - NOT TO SCALE

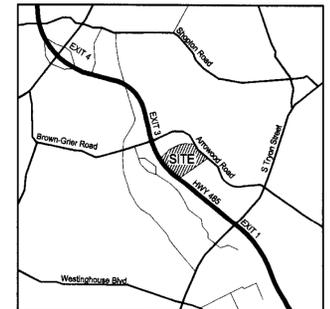

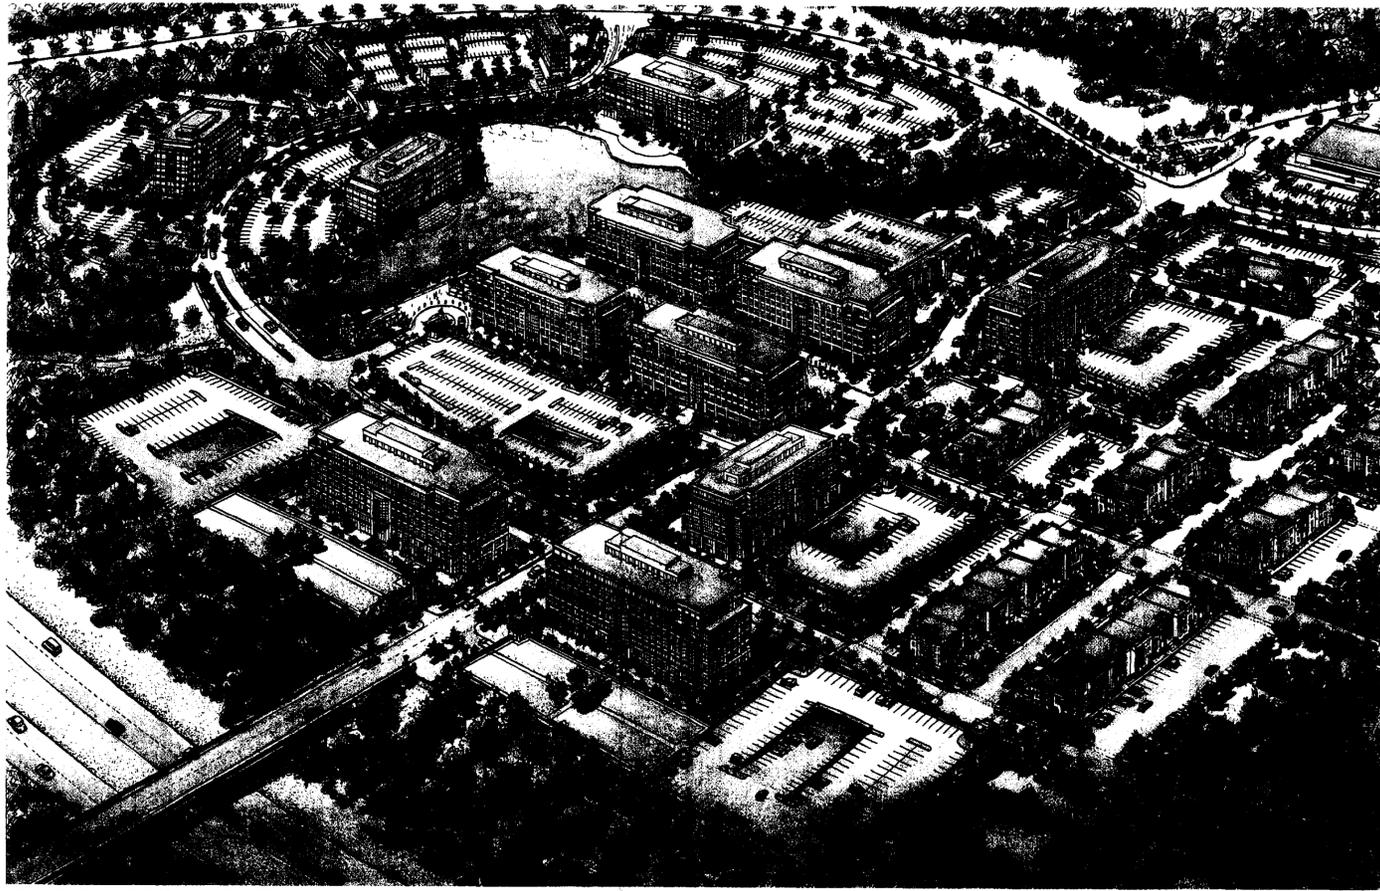

BIRDSEYE PERSPECTIVE TOWARD THE NORTH

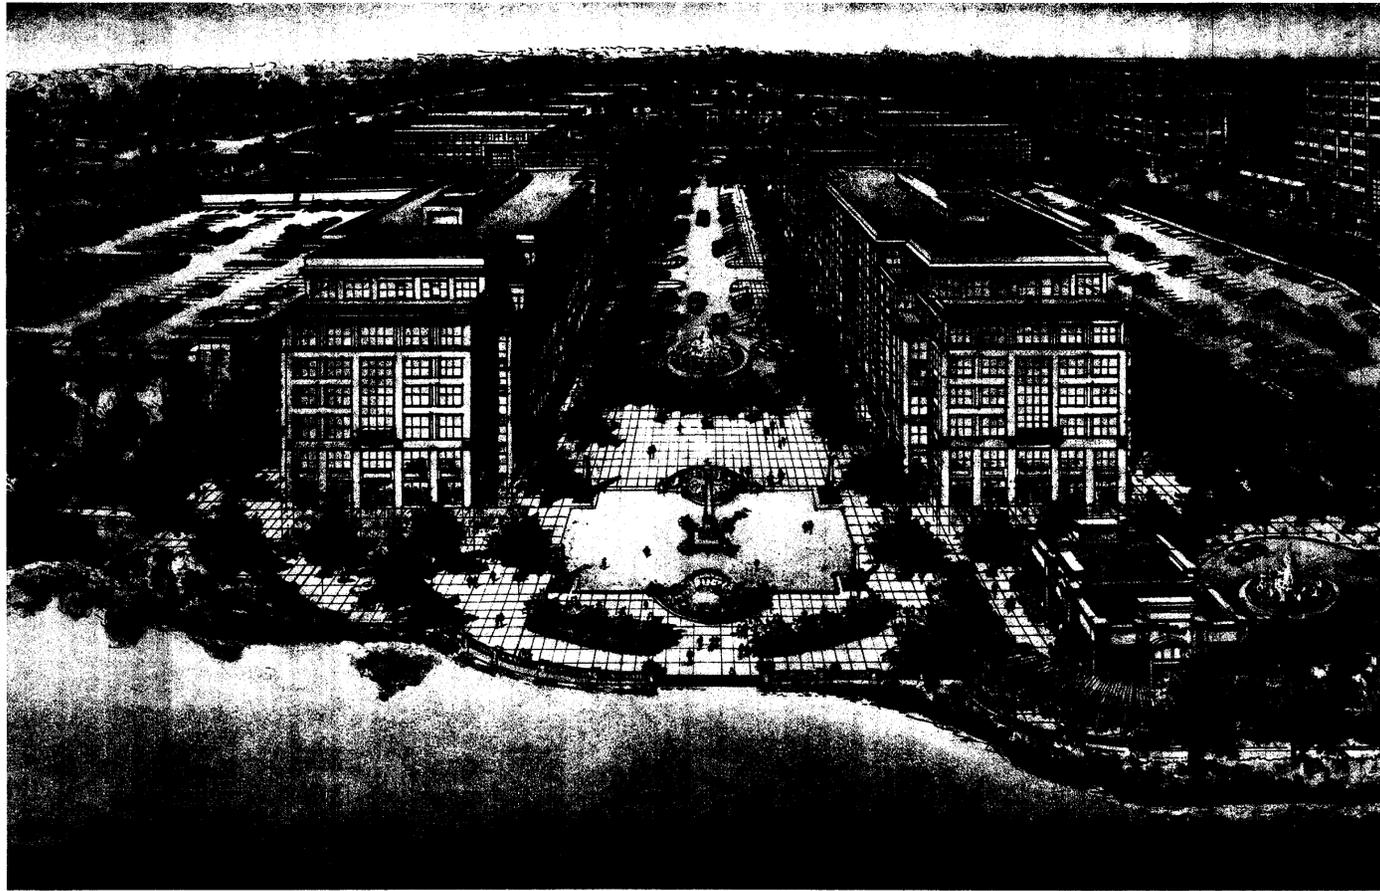

PERSPECTIVE OF AMENITY SPACE AT MOODY LAKE

**LandDesign®**

233 N Graham Street Charlotte, NC 28202  
 V: 704.333.0225 F: 704.332.3246  
 www.LandDesign.com

**WHITEHALL CORPORATE CENTER - PHASE II**

**CHARLOTTE, NC**

AMERICAN ASSET CORPORATION

**PERSPECTIVES**

**REVISIONS:**  
 01/09/09 REVISIONS PER CITY COMMENTS

DATE: 01/25/2008  
 DESIGNED BY: CHK  
 DRAWN BY: HS  
 CHECKED BY: CHK, RPJ  
 O.C. BY: RPJ  
 SCALE:  
 PROJECT #: 1066065

SHEET #:  
**TDS.2.2**

FOR PUBLIC HEARING  
 PETITION NO. 2008-053