43+25
EOP

DRIVEWAY TIE-IN WITHOUT SIDEWALK - OLD CONDITION

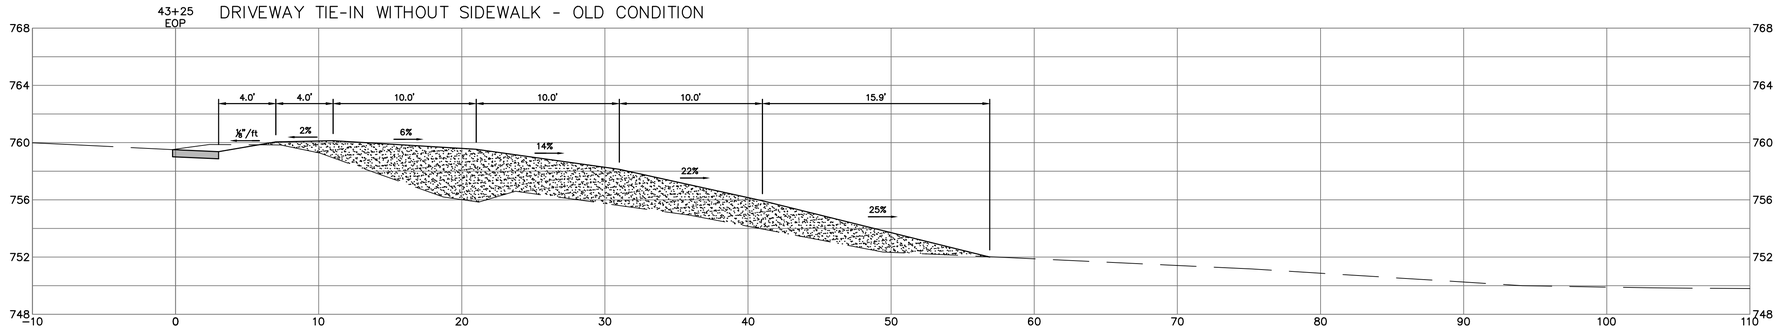

43+25
EOP

SIDEWALK AS BUILT PER CONSTRUCTION PLANS

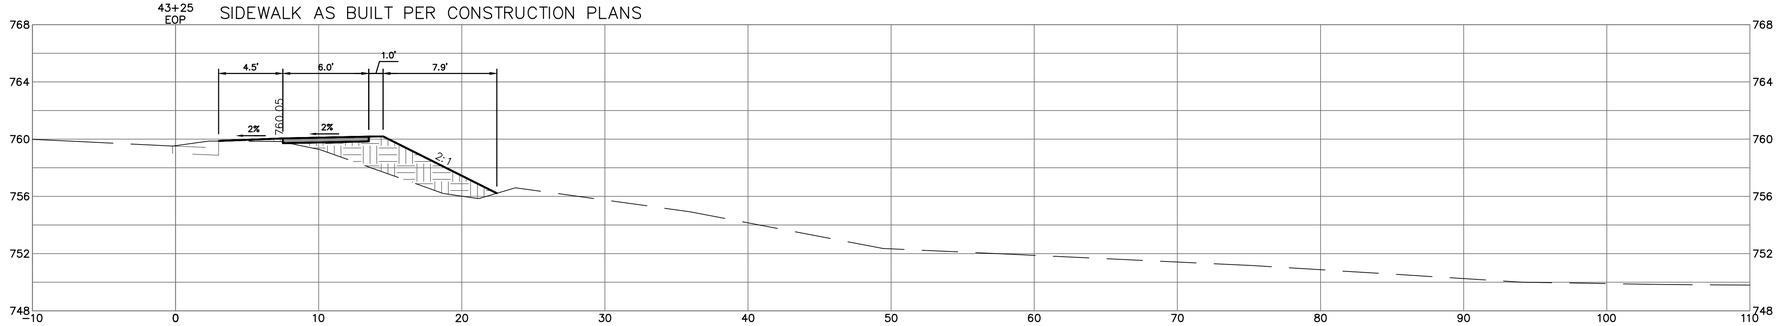

43+25
EOP

DRIVEWAY TIE-IN WITH SIDEWALK - FUTURE CONDITION

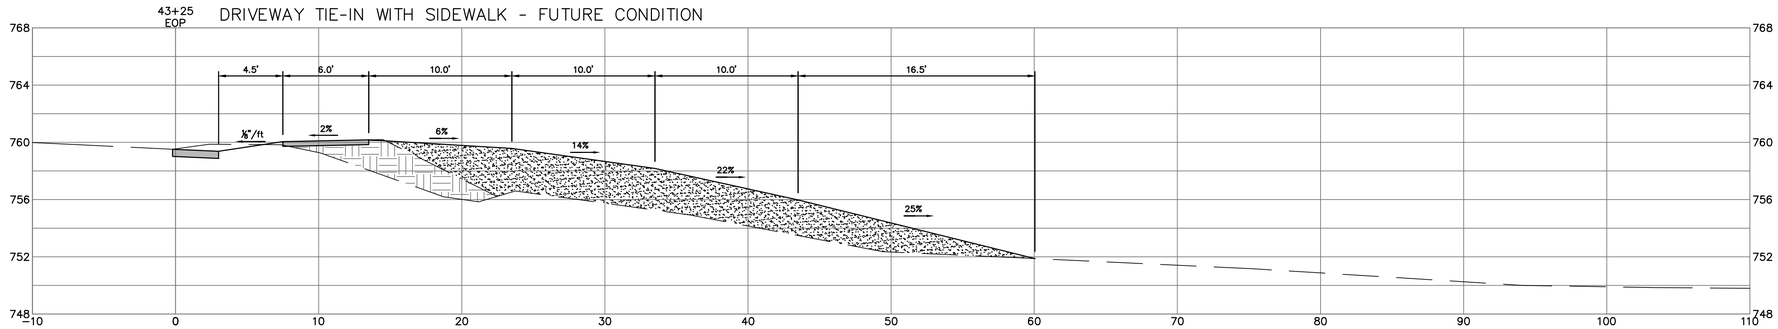

CHARLOTTE.

Plans Prepared By:

BUILDING

FOR CHARLOTTE
CITY OF CHARLOTTE
ENGINEERING & PROPERTY MANAGEMENT
PLANNING & DESIGN GROUP

600 East Fourth Street
Charlotte, North Carolina 28202
Phone: (704) 336-2291
Fax: (704) 336-4566

NO.	DATE	BY	DESCRIPTION

512-08-078
JOB NO.

1" = 20'
SCALE

O:\In-House Design\Project Files\512-08-078 Tuckaseegee Road Sidewalk\Driveways\tuckaseegee parcel 16 cross sections.dgn
CAD FILE PATH

ACB
PREPARED BY

RLC
CHECKED BY

LWH
APPROVED BY

OCT 2009
DATE

TUCKASEEGEE RD SIDEWALKS

CROSS SECTIONS Parcel 16

SHEET

OF

Wednesday, September 21, 2011 1:21:09 PM